
City of Prince George HISTORY SHEET

11322 **Roll Number** SHEET NUMBER 2100 20 Legal: D.L. PLAN 21188 BLOCK LOT'S 3975 Address: HUENE DR. Sanitary Connection: SIZE MATERIAL INV. CONNECTED Water Connection SIZE MATERIAL METER Storm Connection: SIZE MATERIAL INV. CONNECTED Cash Receipt No's: WATER SANITARY STORM CURB FROM PROPERTY LINE PAVEMENT WIDTH UNDERGROUND CONNECTION B.C. HYDRO B.C. TELEPHONE UNDERGROUND CONNECTION INLAND GAŞ Information Sheets:

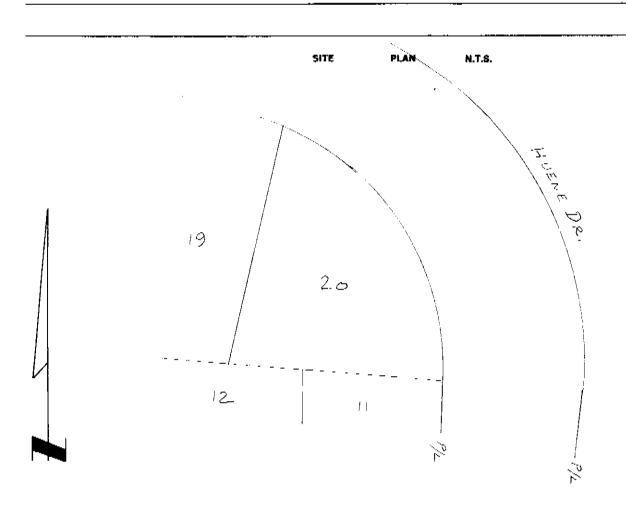

Comments: