



City of Prince George History Sheet

PID:	009632549
SD/MU:	
WO:	

Civic Address: 4010 Lansdowne Rd

Legal Description: Lot: A District Lot: 753 Plan: 21013


Service Type	Diameter (mm)	Material	Invert Elev at main (m)	Invert Elev at property line (m)	Invert Elev at service end (m)	Distance into property (m)	Installation Date
Sanitary	N/A	N/A	-	-	-	-	-
Water	20mm	Copper	-	-	-	-	May 1973
Storm	N/A	N/A	-	-	-	-	

Service Connection Location					Sanitary (m)	Storm (m)
Distance from downstream San MH	-	towards upstream San MH	-	-	-	
Distance from downstream Stm MH	-	towards upstream Stm MH	-	-		

Power	Size	Communications	Size	Cable	Size	Gas	Size
BC Hydro	-	Telus	-	Shaw	-	FortisBC	-
Overhead Service		Overhead Service		Overhead Service			

Installed by:		Survey Date:	-
Comments:	Water service location confirmed April 15, 2019		

NOT TO SCALE The information contained herein is for internal use only.
Not to be relied on unless confirmed by site inspection and/or investigation.

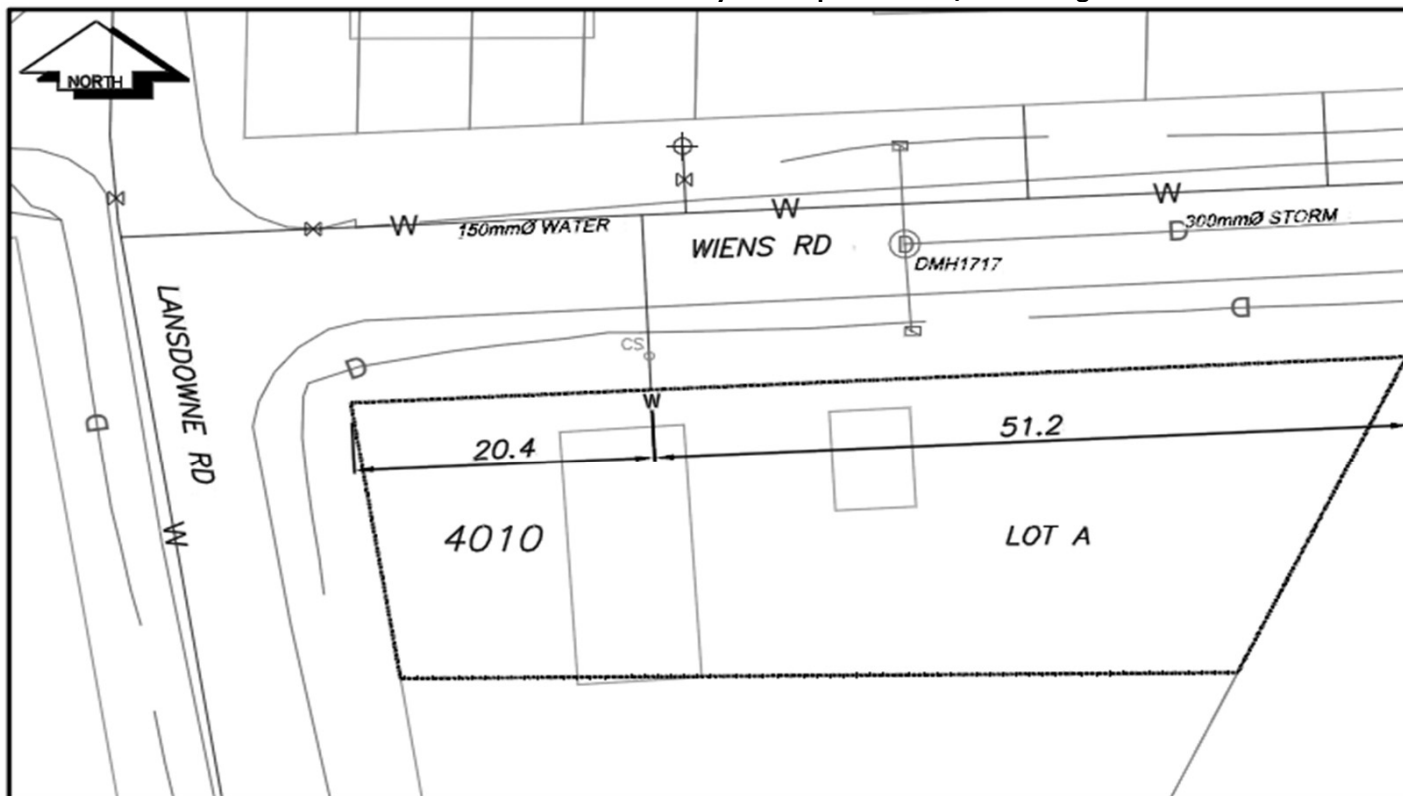

CS CURB STOP	W WATER SERVICE	STORM SERVICE
CO CLEAN OUT	S SANITARY SERVICE	G GAS
WATER VALVE	FIRE HYDRANT	ENCUMBRANCE

NOT TO SCALE