



City of Prince George
History Sheet

PID:	009646183
SD/MU:	MU102517
WO:	5027219/ 5027220

Civic Address: 443 Melville Ave

Legal Description: Lot: 5 Block: 61 District Lot: 343 Plan: 1268


Service Type	Diameter (mm)	Material	Invert Elev at main (m)	Invert Elev at property line (m)	Invert Elev at service end (m)	Distance into property (m)	Installation Date
Sanitary	N/A	N/A	-	-	-	-	-
Water	N/A	N/A	-	-	-	-	-
Storm	N/A	N/A	-	-	-	-	-

Service Connection Location						Sanitary (m)	Storm (m)
Distance from downstream San MH			-	towards upstream San MH	-	-	-
Distance from downstream Stm MH			-	towards upstream Stm MH	-	-	-

Power	Size	Communications	Size	Cable	Size	Gas	Size
BC Hydro	-	Telus	-	Shaw	-	FortisBC	-
Mot Applicable		Mot Applicable		Mot Applicable			

Installed by:	Survey Date:	-
Comments:		

NOT TO SCALE The information contained herein is for internal use only.
Not to be relied on unless confirmed by site inspection and/or investigation.

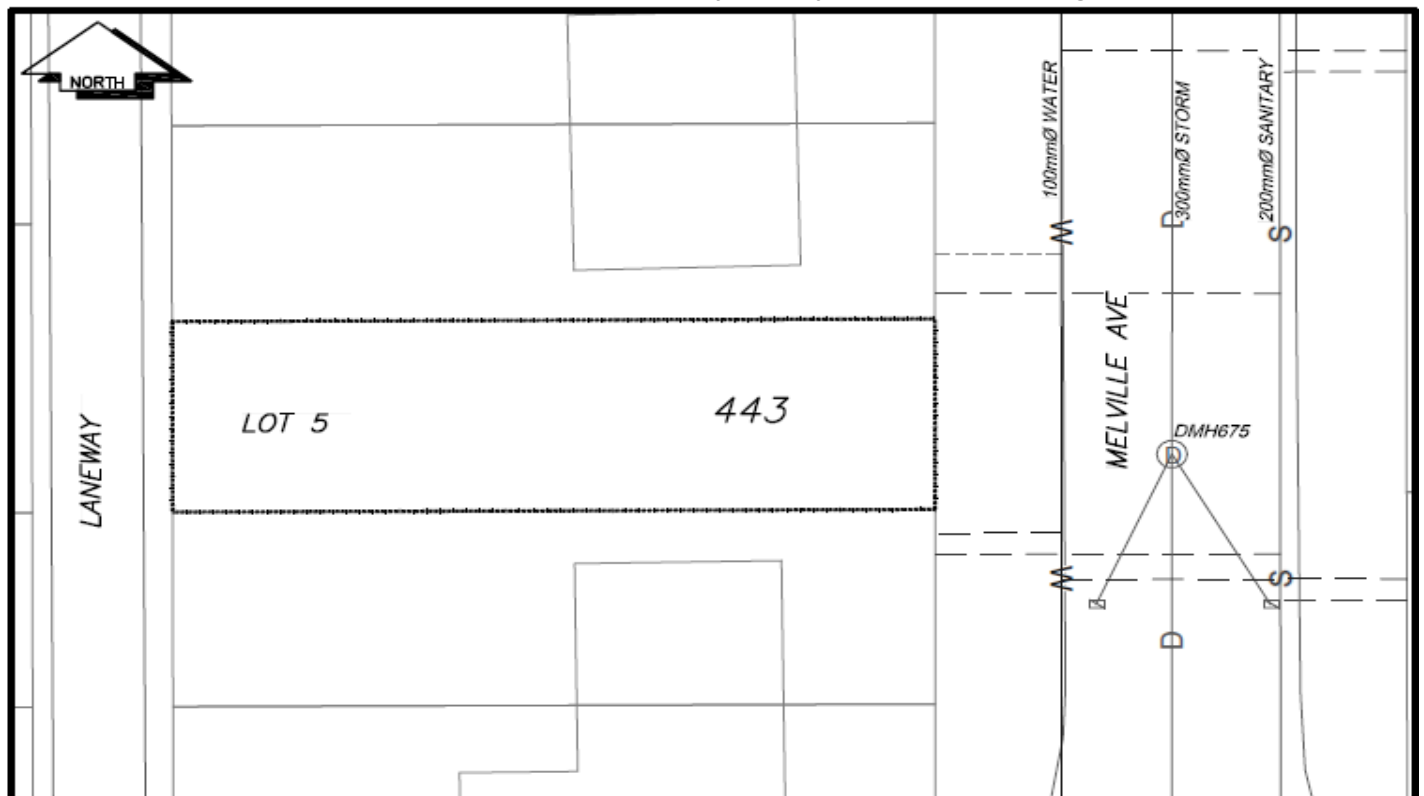

CS ^o CURB STOP	—W— WATER SERVICE	—S— STORM SERVICE
CO ^o CLEAN OUT	- - - - - SANITARY SERVICE	—G— GAS
⊗ WATER VALVE	⊗ FIRE HYDRANT	- - - - - ENCUMBRANCE

NOT TO SCALE