



City of Prince George History Sheet

PID:	009647058
SD/MU:	
WO:	

Civic Address: 7376 Carr Rd

Legal Description: Lot: C District Lot: 2433 Plan: 20492


Service Type	Diameter (mm)	Material	Invert Elev at main (m)	Invert Elev at property line (m)	Invert Depth at service end (m)	Distance into property (m)	Installation Date
Sanitary	100mm	PVC	-	-	2.10	-	January 1980
Water	20mm	Copper	-	-	-	-	January 1972
Storm	N/A	N/A	-	-	-	-	

Service Connection Location				Sanitary (m)	Storm (m)
Distance from downstream San MH	232	towards upstream San MH	206	69.51	
Distance from downstream Stm MH	-	towards upstream Stm MH	-		

Power	Size	Communications	Size	Cable	Size	Gas	Size
BC Hydro	-	Telus	-	Shaw	-	FortisBC	-
Overhead Service		Overhead Service		Overhead Service			

Installed by:	Survey Date:	-
Comments: Water service location confirmed May 03, 2017		

NOT TO SCALE The information contained herein is for internal use only.
Not to be relied on unless confirmed by site inspection and/or investigation.

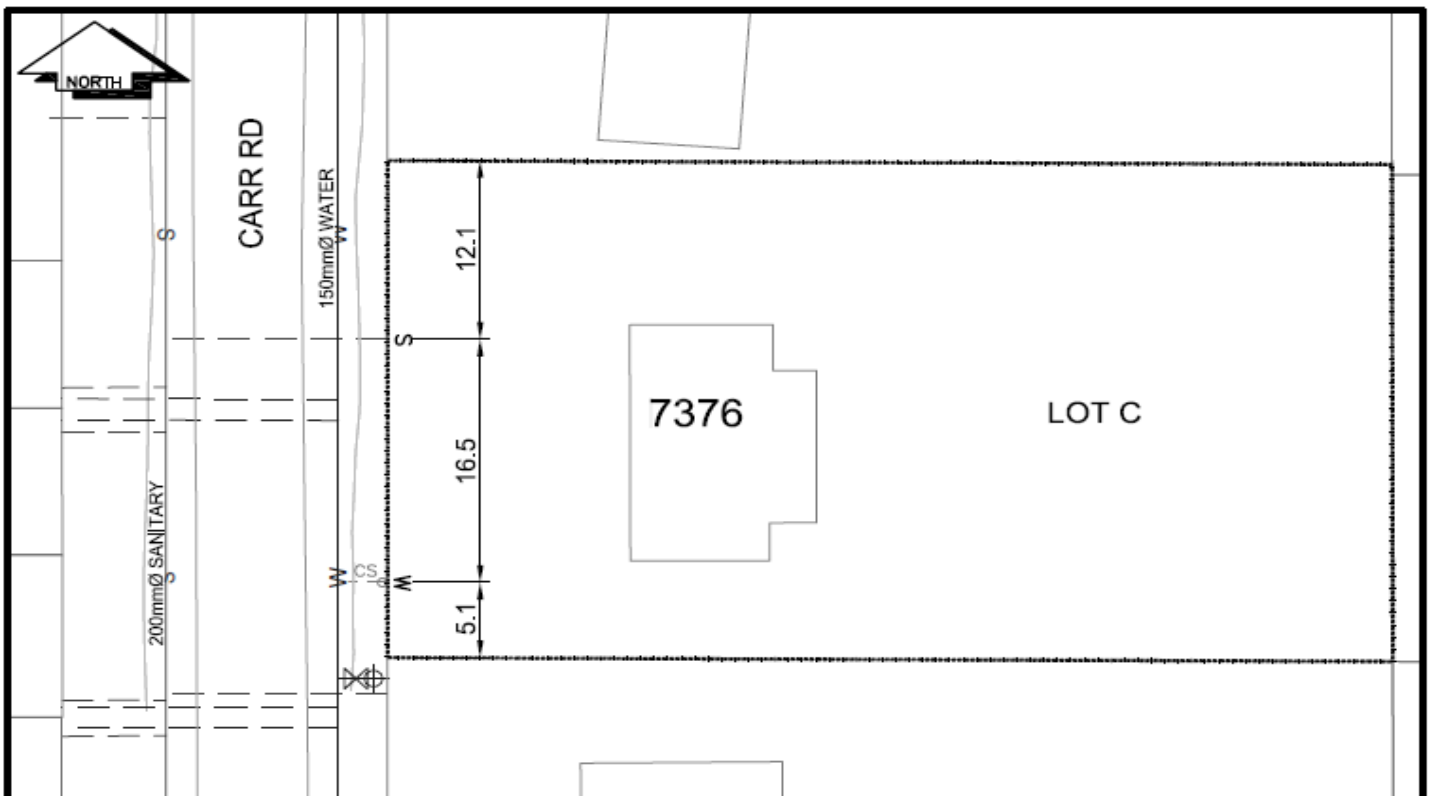

CS ^o CURB STOP	--- W --- WATER SERVICE	--- S --- STORM SERVICE
CO ^o CLEAN OUT	--- S --- SANITARY SERVICE	--- G --- GAS
⊗ WATER VALVE	⊗ FIRE HYDRANT	--- --- ENCUMBERANCE

NOT TO SCALE