
City of Prince George HISTORY SHEET

SHEET NUMBER						Roll	Number (009 <i>678 65</i> 4
Legal:	LOT'S	5	BLOCK		D.L.	754	PLAN	20922
Address:		(0190.	ACADIA	PLACE.				
Sanitary C	onnection: #	RP 85-7-1	SIZE	MATERIAL		INV.		CONNECTED
Water Con	#		SIZE	MATERIAL		METER		CONNECTED
Storm Con	nection:		SIZE	MATERIAL		INV.		CONNECTED
Cash Rece	ipt No's:	WATER		SANITARY			STORM	
CURB FROM PROPERTY LINE 55m			> <i>K</i> Y			PAVEMENT	r WIDTH	9m
B.C. HYDRO	C. HYDRO UNDERGROUND CONNECTION							
B.C. TELEPHONE			UNDERGROUND CONNECTION					
INLAND GAS								,
Information	Sheets:							
Comments								
-							•	

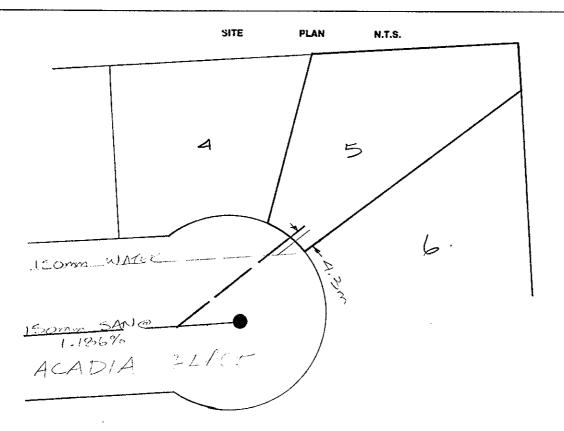

23, 6.6m.