



# City of Prince George History Sheet

PID:	029391946
PID:	009701516
WO:	

Civic Address: 2150 Laurier Cres

Legal Description: Lot: PCL D (CA3961610) Block: 70 District Lot: 343 Plan: 1268

Lot: 8 PCL A (B13069 Block: 70 District Lot: 343 Plan: 1268


Service Type	Diameter (mm)	Material	Invert Elev at main (m)	Depth of Cut at property line (m)	Invert Elev at service end (m)	Distance into property (m)	Installation Date
Sanitary	100mm	PVC	-	1.52	-	-	January 1957
Water	20mm	Copper	-	-	-	-	
Storm	N/A	N/A	-	-	-	-	

Service Connection Location				Sanitary (m)	Storm (m)
Distance from downstream San MH	2674	towards upstream San MH	999	99.90	
Distance from downstream Stm MH	-	towards upstream Stm MH	-	-	

Power	Size	Communications	Size	Cable	Size	Gas	Size
BC Hydro	-	Telus	-	Shaw	-	FortisBC	-
Overhead Service		Overhead Service		Overhead Service			

Installed by:	Survey Date:	January 01, 1957
Comments:		

**NOT TO SCALE** The information contained herein is for internal use only.  
Not to be relied on unless confirmed by site inspection and/or investigation.

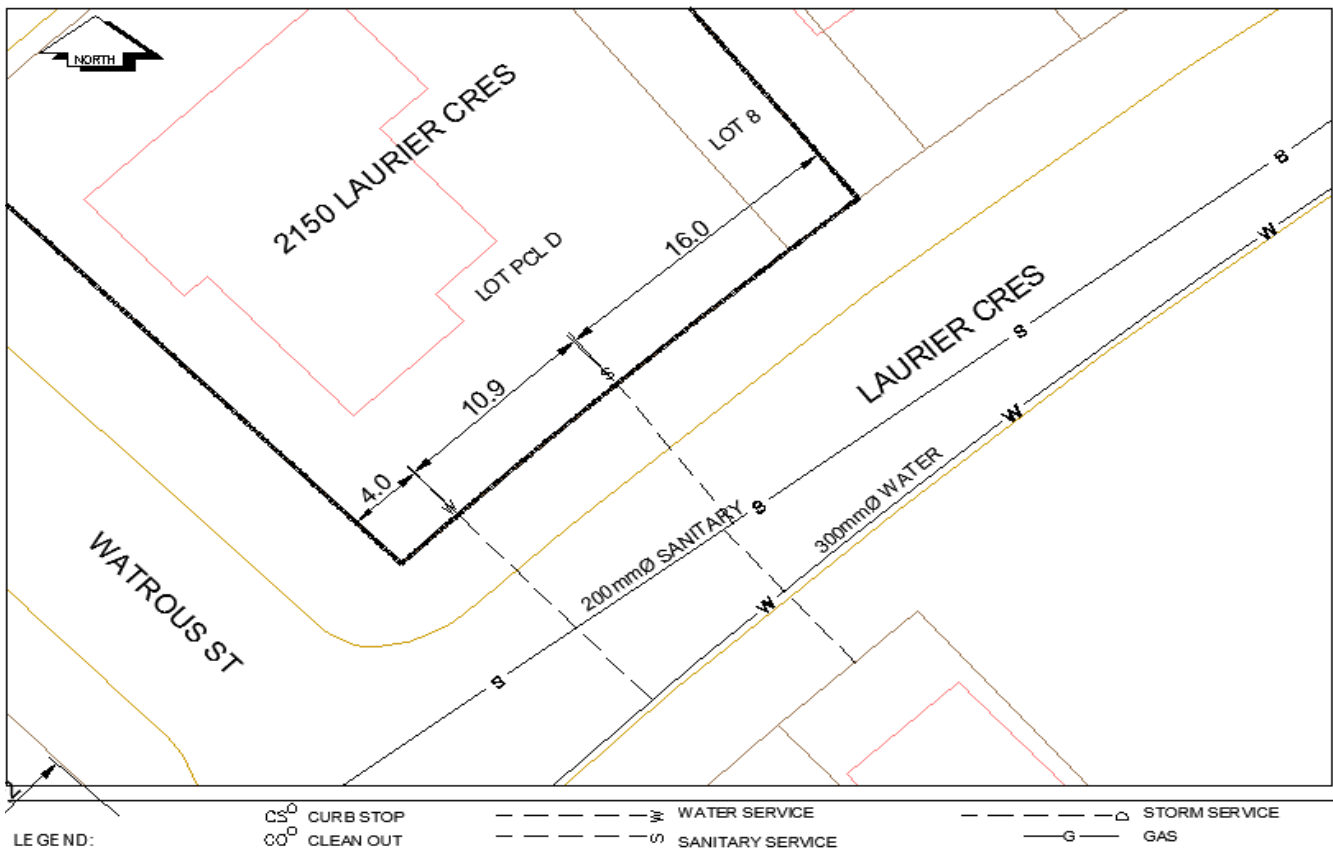

**NOT TO SCALE**