



City of Prince George History Sheet

PID:	009701648
PID:	12582212
WO:	

Civic Address: 687 Burden St

Legal Description: Lot: 8 District Lot: 343, Block: 74, Plan: 1268

Lot: A District Lot: 343, Plan: 11053


Service Type	Diameter (mm)	Material	Invert Elev at main (m)	Invert Elev at property line (m)	Invert Elev at service end (m)	Distance into property (m)	Installation Date
Sanitary	100mm	PVC	-	-	-	-	-
Water	20mm	Copper	-	-	-	-	-
Storm	N/A	N/A	-	-	-	-	-

Service Connection Location				Sanitary (m)	Storm (m)
Distance from downstream San MH	2678	towards upstream San MH	2673	38.10	
Distance from downstream Stm MH	-	towards upstream Stm MH	-		

Power	Size	Communications	Size	Cable	Size	Gas	Size
BC Hydro	-	Telus	-	Shaw	-	FortisBC	-
Overhead Service		Overhead Service		Overhead Service			

Installed by:	City of Prince George forces	Survey Date:	
Comments:			

NOT TO SCALE The information contained herein is for internal use only.
Not to be relied on unless confirmed by site inspection and/or investigation.

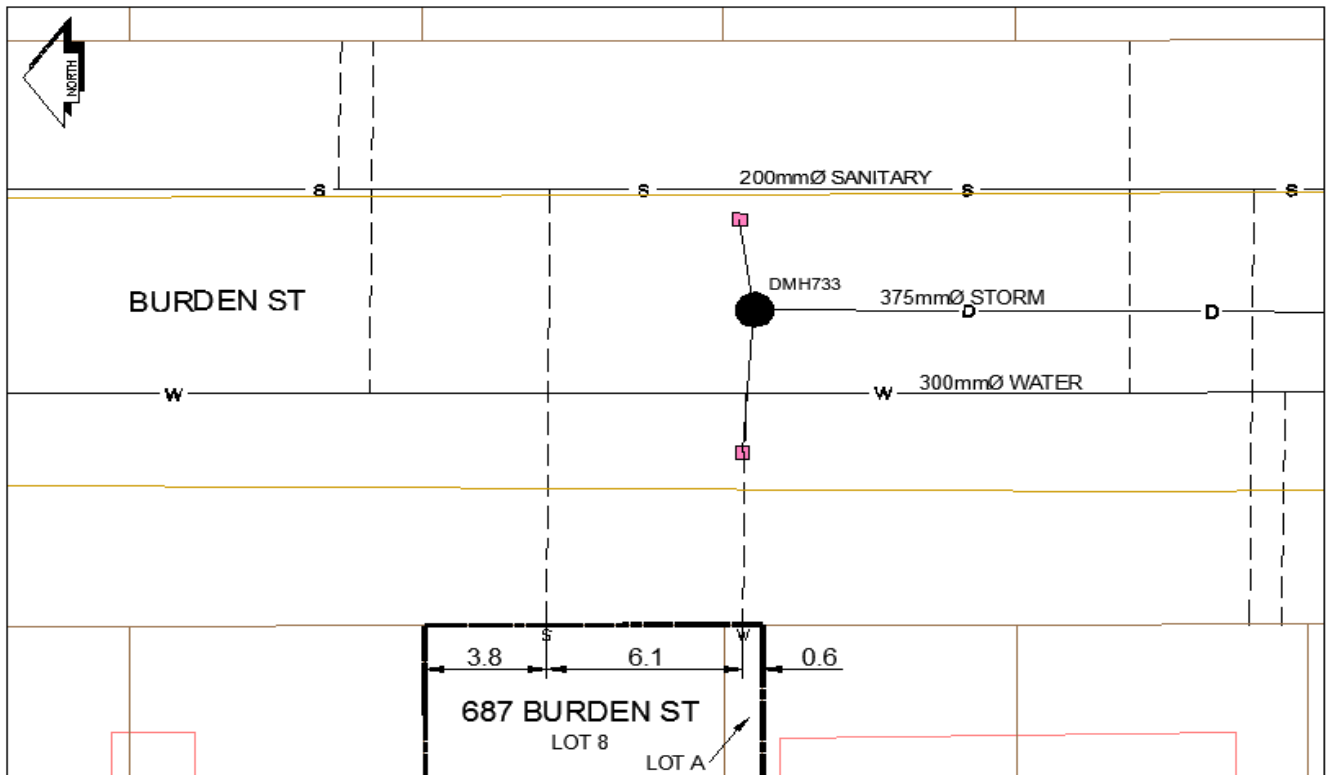

LEGEND: CS CURB STOP CO CLEAN OUT WATER SERVICE SANITARY SERVICE STORM SERVICE GAS

NOT TO SCALE