



# City of Prince George History Sheet

PID:	009701711
SD/MU:	
WO:	

Civic Address: 744 Carney St

Legal Description: Lot: PCL C, Block: 75, District Lot: 343 Plan: 1268


Service Type	Diameter (mm)	Material	Invert Elev at main (m)	Depth of cut at property line (m)	Invert Elev at service end (m)	Distance into property (m)	Installation Date
Sanitary	100mm	PVC	-	1.25	-	-	August 29, 1958
Water	20mm	Copper	-	-	-	-	
Storm	N/A	N/A	-	-	-	-	

Service Connection Location				Sanitary (m)	Storm (m)
Distance from downstream San MH	1969	towards upstream San MH	2668	58.30	
Distance from downstream Stm MH	-	towards upstream Stm MH	-		

Power	Size	Communications	Size	Cable	Size	Gas	Size
BC Hydro	-	Telus	-	Shaw	-	FortisBC	-
Overhead Service		Overhead Service		Overhead Service			

Installed by:	Survey Date:	August 29, 1958
Comments:		

**NOT TO SCALE** The information contained herein is for internal use only.  
Not to be relied on unless confirmed by site inspection and/or investigation.

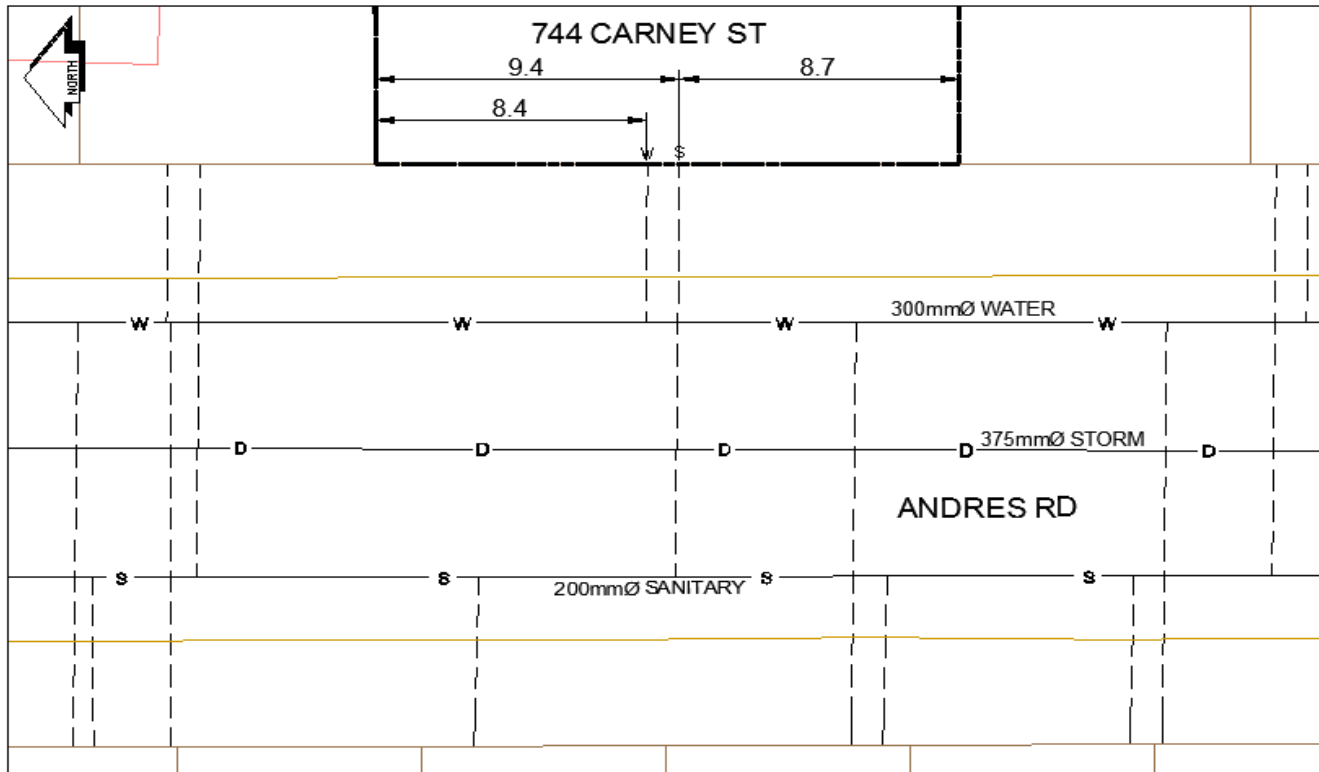

LEGEND: CS<sup>o</sup> CURB STOP      — — — — — WATER SERVICE      — — — — — STORM SERVICE  
CO<sup>o</sup> CLEAN OUT      — — — — — SANITARY SERVICE      — — — — — GAS

**NOT TO SCALE**