



City of Prince George  
**History Sheet**

PID:	009702270
	009702288
SD/MU:	
WO:	

Civic Address: 599 Melville Ave

Legal Description: Lot: 24, 25 Block: 70 District Lot: 343 Plan: 1268


Service Type	Diameter (mm)	Material	Invert Elev at main (m)	Invert Elev at property line (m)	Invert Elev at service end (m)	Distance into property (m)	Installation Date
Sanitary	100mm	AC	-	-	-	-	December 1956
Water	20mm	Copper	-	-	-	-	December 1957
Storm	N/A	N/A	-	-	-	-	

Service Connection Location	Sanitary (m)	Storm (m)
100mm sanitary service connected to san MH993	-	
Distance from downstream Stm MH - towards upstream Stm MH -		

Power	Size	Communications	Size	Cable	Size	Gas	Size
BC Hydro	-	Telus	-	Shaw	-	FortisBC	-
Overhead Service		Overhead Service		Overhead Service			

Installed by:	Survey Date:	-
Comments: Water service location confirmed in May 2019		

**NOT TO SCALE** The information contained herein is for internal use only.  
**Not to be relied on unless confirmed by site inspection and/or investigation.**

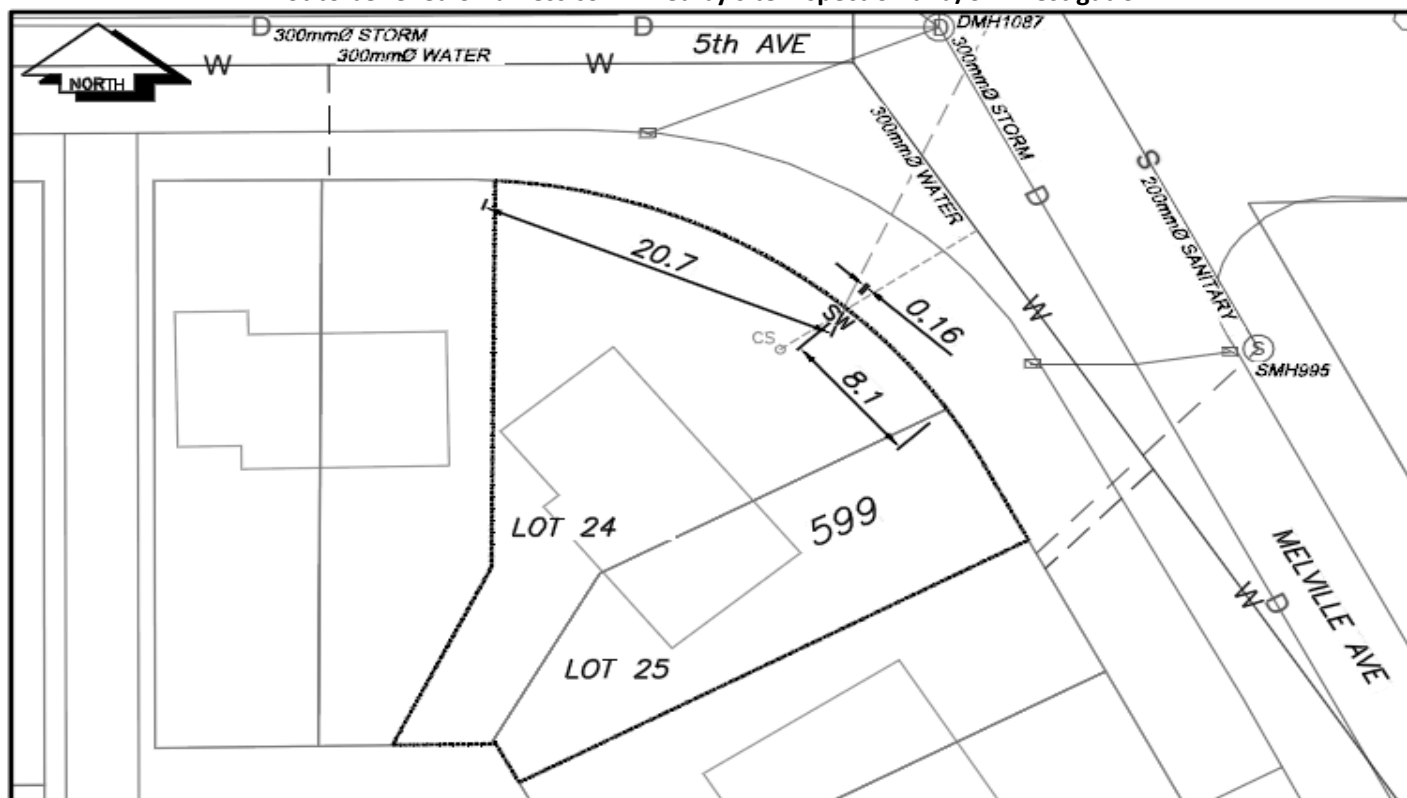

CS CURB STOP	--- WATER SERVICE	--- STORM SERVICE
CO CLEAN OUT	--- SANITARY SERVICE	--- GAS
WV WATER VALVE	--- FIRE HYDRANT	--- ENCUMBRANCE

**NOT TO SCALE**