

City of Prince George HISTORY SHEET

007107 511

SHEET NUMBER

Roll Number

Legal: LOT'S 267 BLOCK — D.L. 482 PLAN 20916

Address: 4561 5TH AVE

Sanitary Connection: # 8753 SIZE 100 mm MATERIAL A.C. INV. — CONNECTED

Water Connection # 8753 SIZE 20 mm MATERIAL CU METER — CONNECTED

Storm Connection: # — SIZE — MATERIAL — INV. — CONNECTED

Cash Receipt No's: WATER — SANITARY — STORM —

CURB FROM PROPERTY LINE 4.877 m PAVEMENT WIDTH 10.363 m

B.C. HYDRO U/G UNDERGROUND CONNECTION


B.C. TELEPHONE U/G UNDERGROUND CONNECTION

INLAND GAS AS SHOWN


Information Sheets:

Comments: WITH THAW WIRE.

**THE INFORMATION CONTAINED HEREIN IS FOR INTERNAL USE ONLY.
NOT TO BE RELIED UPON UNLESS CONFIRMED BY SITE INSPECTION AND/OR INVESTIGATION**

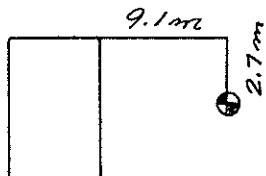

5th AVE.

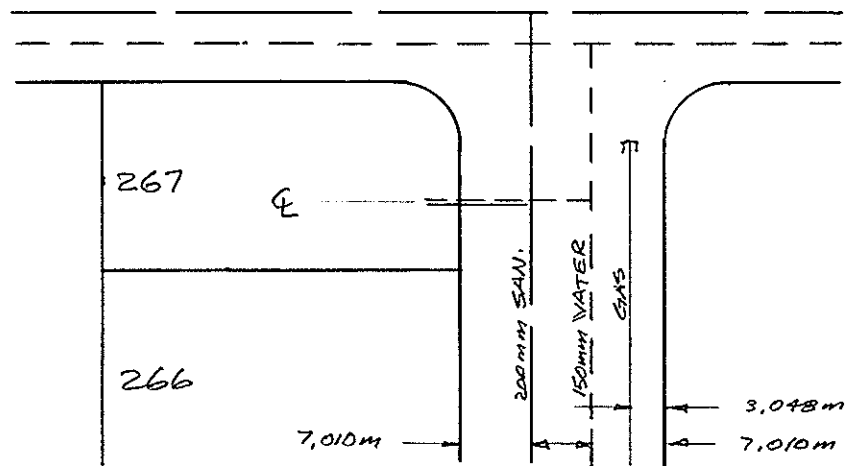

VALLEY CRES.