
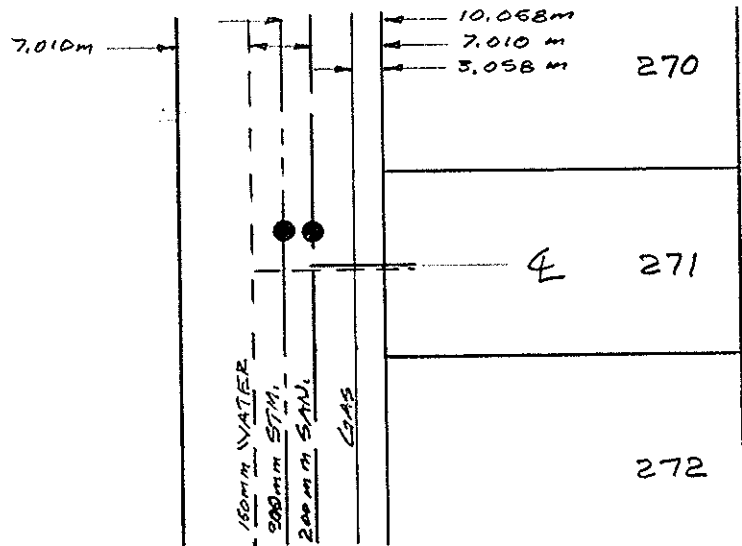


# City of Prince George HISTORY SHEET

004 103 451  
FM

SHEET NUMBER				Roll Number			
Legal:	LOT'S	271	BLOCK	—	D.L.	482	PLAN 20916
Address: 538 WOLVERINE ST.							
Sanitary Connection:		# 8757	SIZE 100 mm	MATERIAL A.C.	INV.	CONNECTED	
Water Connection		# 8757	SIZE 20 mm	MATERIAL COPPER	METER	CONNECTED	
Storm Connection:		#	SIZE	MATERIAL	INV.	CONNECTED	
Cash Receipt No's:		WATER		SANITARY		STORM	
CURB FROM PROPERTY LINE		4.877 m		PAVEMENT WIDTH		10.363 m	
B.C. HYDRO		UG		UNDERGROUND CONNECTION			
B.C. TELEPHONE		UG		UNDERGROUND CONNECTION			
INLAND GAS		AS SHOWN					
Information Sheets:							
Comments: WITH THAW WIRE.							

THE INFORMATION CONTAINED HEREIN IS FOR INTERNAL USE ONLY.  
NOT TO BE RELIED UPON UNLESS CONFIRMED BY SITE INSPECTION AND/OR INVESTIGATION

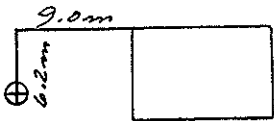

WOLVERINE  
ST.