
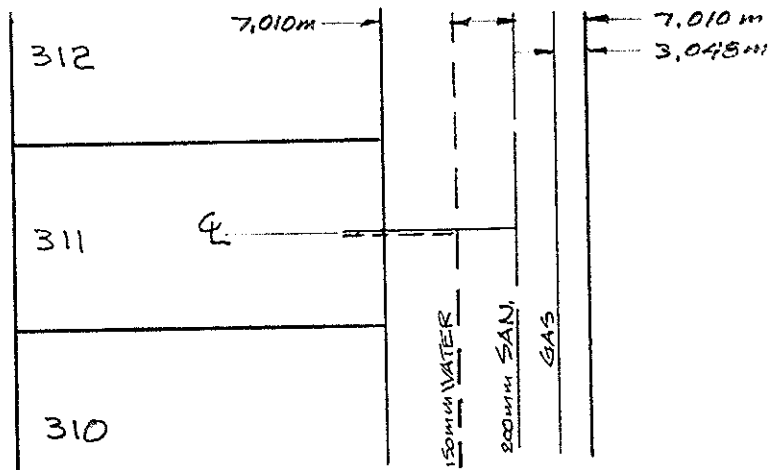


# City of Prince George HISTORY SHEET

-7100750  
FM

SHEET NUMBER				Roll Number	
Legal:	LOT'S	311	BLOCK	—	D.L. 482
PLAN 20916					
Address: 511 ZILLMER ST.					
Sanitary Connection:	#	8796	SIZE	100 mm	MATERIAL A.C. INV. CONNECTED
Water Connection	#	8796	SIZE	20 mm	MATERIAL COPPER METER CONNECTED
Storm Connection:	#		SIZE		MATERIAL INV. CONNECTED
Cash Receipt No's:	WATER		SANITARY		STORM
CURB FROM PROPERTY LINE	4.877 m		PAVEMENT WIDTH		10.363 m
B.C. HYDRO	U/G		UNDERGROUND CONNECTION		
B.C. TELEPHONE	U/G		UNDERGROUND CONNECTION		
INLAND GAS	AS SHOWN				
Information Sheets:					
Comments: WITH THAW WIRE.					

**THE INFORMATION CONTAINED HEREIN IS FOR INTERNAL USE ONLY.  
NOT TO BE RELIED UPON UNLESS CONFIRMED BY SITE INSPECTION AND/OR INVESTIGATION**

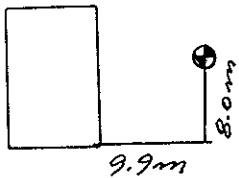

ZILLMER ST.