
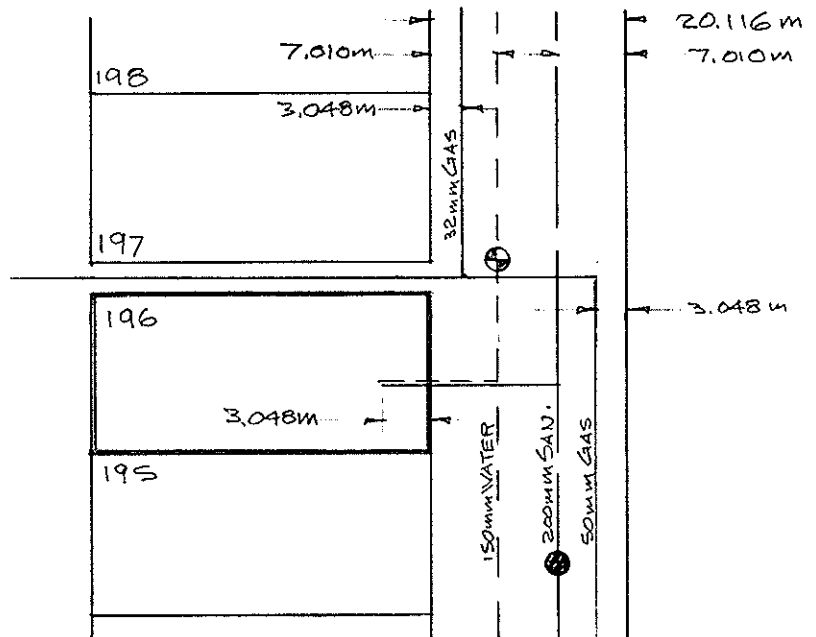


**City of Prince George
HISTORY SHEET**

009709675

SHEET NUMBER		Roll Number			
Legal:	LOT'S 196	BLOCK	D.L. 482	PLAN	20916
Address: 609 PILOT ST.					
Sanitary Connection:	# 8682	SIZE 100mm	MATERIAL A.C.	INV.	CONNECTED
Water Connection	# 8682	SIZE 20mm	MATERIAL C.U.	METER	CONNECTED
Storm Connection:	#	SIZE	MATERIAL	INV.	CONNECTED
Cash Receipt No's:		WATER	SANITARY	STORM	
CURB FROM PROPERTY LINE		4.877 m		PAVEMENT WIDTH 10.363 m	
B.C. HYDRO	U/G		UNDERGROUND CONNECTION		
B.C. TELEPHONE	U/G		UNDERGROUND CONNECTION		
INLAND GAS	AS SHOWN				
Information Sheets:					
Comments:					

**THE INFORMATION CONTAINED HEREIN IS FOR INTERNAL USE ONLY.
NOT TO BE RELIED UPON UNLESS CONFIRMED BY SITE INSPECTION AND/OR INVESTIGATION**

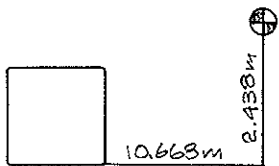

PILOT ST.