

City of Prince George  
HISTORY SHEET

009 709 738

SHEET NUMBER

Roll Number

Legal: LOT'S 198 BLOCK D.L. 482 PLAN 20916

Address: 587 PILOT ST.

Sanitary Connection: # 8684 SIZE 100 mm MATERIAL A.C. INV. CONNECTED

Water Connection # 8684 SIZE 20 mm MATERIAL C.U. METER CONNECTED

Storm Connection: # SIZE MATERIAL INV. CONNECTED

Cash Receipt No's: WATER SANITARY STORM

CURB FROM PROPERTY LINE 4.877 m PAVEMENT WIDTH 10.363 m

B.C. HYDRO U/G UNDERGROUND CONNECTION



B.C. TELEPHONE U/G UNDERGROUND CONNECTION

INLAND GAS AS SHOWN

Information Sheets:

Comments:

THE INFORMATION CONTAINED HEREIN IS FOR INTERNAL USE ONLY.  
NOT TO BE RELIED UPON UNLESS CONFIRMED BY SITE INSPECTION AND/OR INVESTIGATION

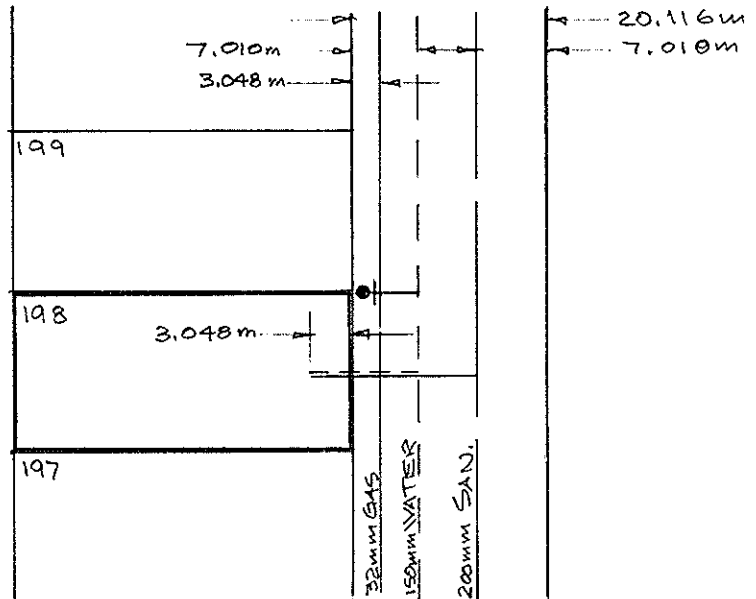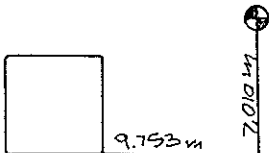

PILOT ST.