

City of Prince George HISTORY SHEET

SHEET NUMBER

Roll Number 609212 286

Legal: LOT'S 98 BLOCK D.L. 482 PLAN 20916

Address: 556 PILOT ST.

Sanitary Connection: # 8665 SIZE 100 mm MATERIAL A.C. INV. CONNECTED

Water Connection # 8665 SIZE 20 mm MATERIAL C.V. METER CONNECTED

Storm Connection: # SIZE MATERIAL INV. CONNECTED

Cash Receipt No's: WATER SANITARY STORM

CURB FROM PROPERTY LINE 4.877 m PAVEMENT WIDTH 10.363 m

B.C. HYDRO U/G UNDERGROUND CONNECTION



B.C. TELEPHONE U/G UNDERGROUND CONNECTION

INLAND GAS AS SHOWN

Information Sheets:

Comments:

**THE INFORMATION CONTAINED HEREIN IS FOR INTERNAL USE ONLY.
NOT TO BE RELIED UPON UNLESS CONFIRMED BY SITE INSPECTION AND/OR INVESTIGATION**

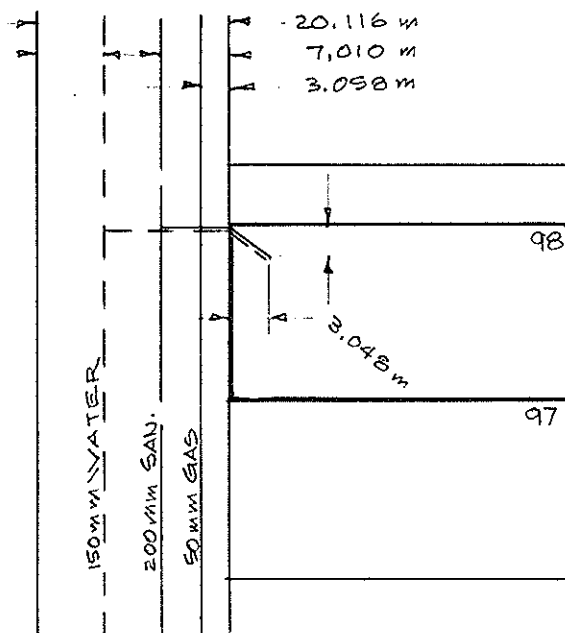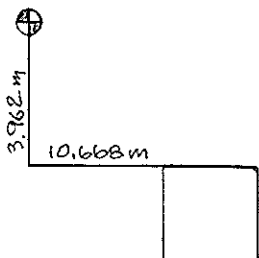

PILOT ST.