

City of Prince George  
HISTORY SHEET

FM

SHEET NUMBER

Roll Number 3094209-4

Legal: LOT'S 17 BLOCK D.L. 2507 PLAN 20916

Address: 767 OCHAKWIN CRES

Sanitary Connection: # 8813 SIZE 4" MATERIAL A<sub>2</sub> INV. CONNECTED

Water Connection # 8813 SIZE 3/4" MATERIAL Cu METER CONNECTED

Storm Connection: # SIZE MATERIAL INV. CONNECTED

Cash Receipt No's: WATER SANITARY STORM

CURB FROM PROPERTY LINE PAVEMENT WIDTH

B.C. HYDRO UNDERGROUND CONNECTION



B.C. TELEPHONE UNDERGROUND CONNECTION

INLAND GAS

Information Sheets:

Comments:

THE INFORMATION CONTAINED HEREIN IS FOR INTERNAL USE ONLY.  
NOT TO BE RELIED UPON UNLESS CONFIRMED BY SITE INSPECTION AND/OR INVESTIGATION

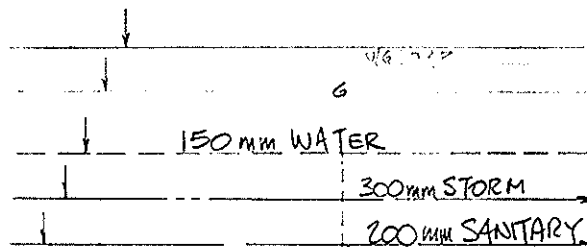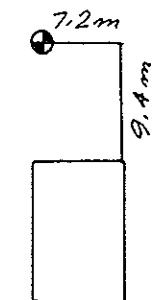

OCHAKWIN  
CRES

