
City of Prince George

HISTORY SHEET						
SHEET NUMBER				Rol	Number (1946)	
Legal: Lot's	107	BLOCK		D.L. 2507	PLAN 20829	
Address:	4242	NESS	AVE.			
Sanitary Connection	on: # 8437	SIZE 100 mm	MATERIAL A	i.C. INV.	CONNECTED	
Water Connection	# 8437	SIZE 20 MM	MATERIAL C	→U · METER	CONNECTED	
Storm Connection:	#	SIZE	MATERIAL	INV.	CONNECTED	
Cash Receipt No's:	WATER		SANITARY		STORM	
CURB FROM PROPERTY	LINE 4.877 W	1		PAVEMEN	NT WIDTH 10,363 M	
B.C. HYDRO	U/G		UNDERGROUNI	CONNECTION		
B.C. TELEPHONE	ELEPHONE U/G			UNDERGROUND CONNECTION		
INLAND GAS	AS SHOW	<i>JN</i>				
Information Sheets						
Comments:						
		ITION CONTAINED I				
NOT TO E	BE RELIED UPON U	NLESS CONFIRMED	BY SITE IN	SPECTION AND/	OR INVESTIGATION	
m S				1 _	109	



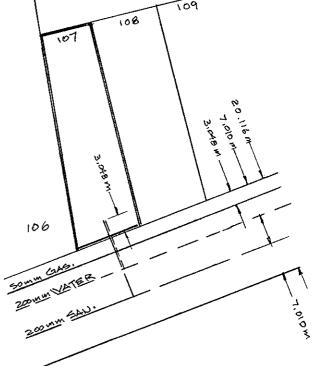

NESS AVE.