

City of Prince George
HISTORY SHEET

DS

009723088

SHEET NUMBER **7494** Roll Number

Legal: LOT'S 14 BLOCK D.L. 808 PLAN 20832

Address: 2470 PROGRESS RD.

Sanitary Connection: # SIZE MATERIAL INV. CONNECTED

Water Connection # SIZE MATERIAL METER CONNECTED

Storm Connection: # SIZE MATERIAL INV. CONNECTED

Cash Receipt No's: WATER SANITARY STORM

CURB FROM PROPERTY LINE PAVEMENT WIDTH

B.C. HYDRO UNDERGROUND CONNECTION


B.C. TELEPHONE UNDERGROUND CONNECTION

INLAND GAS

Information Sheets:

Comments:

SITE PLAN N.T.S.

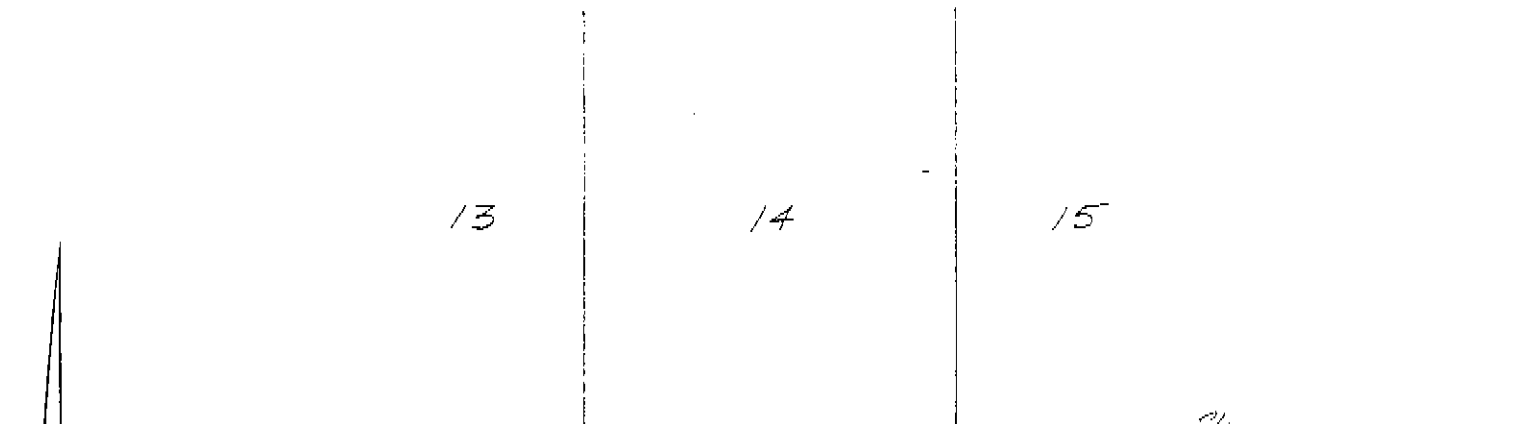

P/L

PROGRESS RD.

