



# City of Prince George History Sheet

PID:	009788085
PID:	009788115
WO:	

Civic Address: 2160 Laurier Cres

Legal Description: Lot: 1 Block: 71 District Lot: 343 Plan: 1268

Lot: 2 Block: 71 District Lot: 343 Plan: 1268


Service Type	Diameter (mm)	Material	Invert Elev at main (m)	Depth of Cut at property line (m)	Invert Elev at service end (m)	Distance into property (m)	Installation Date
Sanitary	100mm	PVC	-	2.31	-	-	July 1958
Water	20mm	Copper	-	-	-	-	January 1957
Storm	N/A	N/A	-	-	-	-	

Service Connection Location				Sanitary (m)	Storm (m)
Distance from downstream San MH	2674	towards upstream San MH	2679	17.60	
Distance from downstream Stm MH	-	towards upstream Stm MH	-		

Power	Size	Communications	Size	Cable	Size	Gas	Size
BC Hydro	-	Telus	-	Shaw	-	FortisBC	-
Overhead Service		Overhead Service		Overhead Service			

Installed by:	City of Prince George forces	Survey Date:	-
Comments:			

**NOT TO SCALE** The information contained herein is for internal use only.  
Not to be relied on unless confirmed by site inspection and/or investigation.

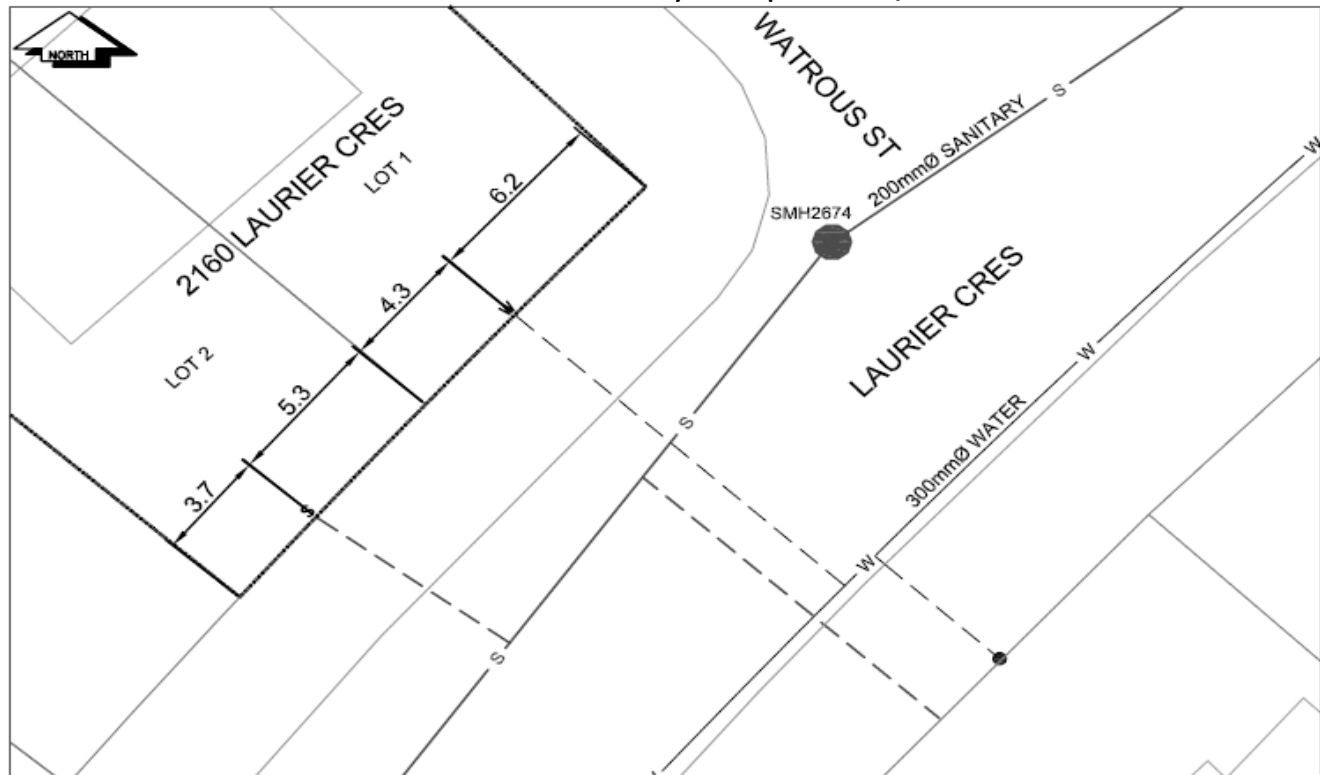

CS <sup>o</sup>	CURB STOP	---	WATER SERVICE	---	STORM SERVICE
CO <sup>o</sup>	CLEAN OUT	---	SANITARY SERVICE	---	GAS

**NOT TO SCALE**