


City of Prince George
HISTORY SHEET

009788361
009788409

SHEET NUMBER	529			Roll Number	1583-000		
Legal:	LOT'S 16-17	BLOCK 74	D.L. 343	PLAN 1268			
Address:	1740-9TH AVE. PRINCE GEORGE, BC. (642 CARNEY ST.)						
Sanitary Connection:	# 969	SIZE -	MATERIAL -	INV. 1928.32	CONNECTED	YES.	
Water Connection	# 100	SIZE -	MATERIAL -	METER -	CONNECTED	-	
Storm Connection:	# -	SIZE -	MATERIAL -	INV. -	CONNECTED	-	
Cash Receipt No's:	WATER -		SANITARY 1676		STORM -		
CURB FROM PROPERTY LINE	12'			PAVEMENT WIDTH	42'		
B.C. HYDRO	O.H.			UNDERGROUND CONNECTION	-		
B.C. TELEPHONE	O.H.			UNDERGROUND CONNECTION	-		
INLAND GAS	IN LANE 9 CARNEY ST. 6" ϕ MAINS.						
Information Sheets:	-						
Comments:	SAN, TOP OF WATER MAINS						
THE INFORMATION CONTAINED HEREIN IS FOR INTERNAL USE ONLY. NOT TO BE RELIED UPON UNLESS CONFIRMED BY SITE INSPECTION AND/OR INVESTIGATION.							

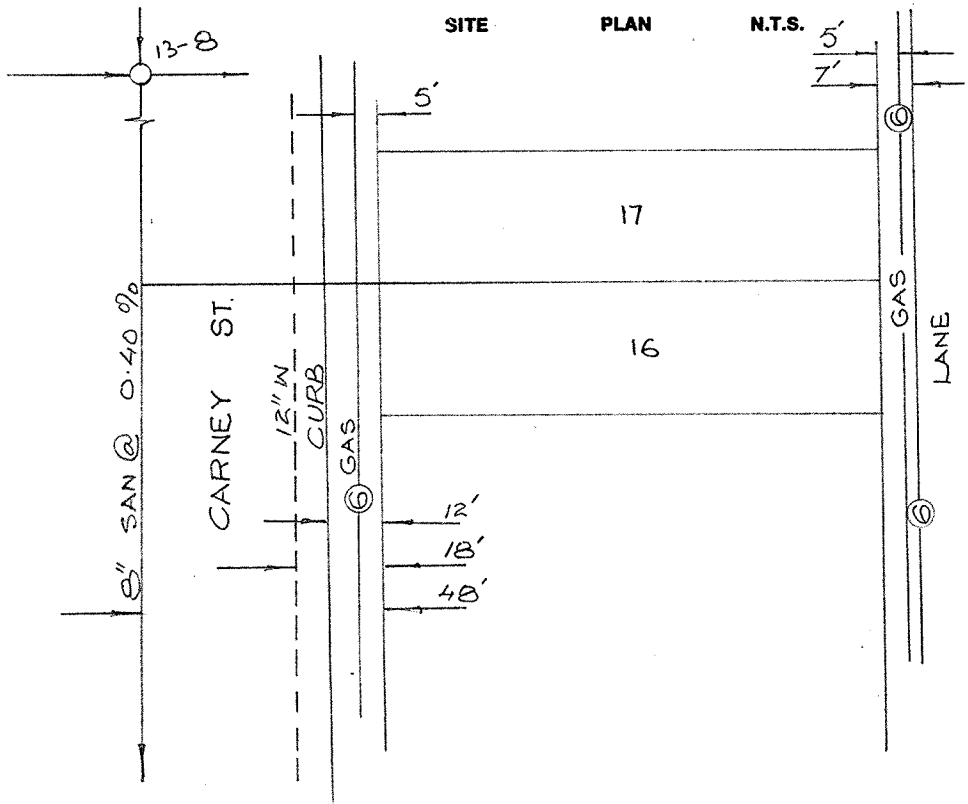

House located on Lot 17
was demolished 2006
(DD000817)

