



City of Prince George  
**History Sheet**

PID:	009788654
SD/MU:	
WO:	

Civic Address: 708 710 Carney St

Legal Description: Lot: 20 Block: 75 District Lot: 343 Plan: 1268


Service Type	Diameter (mm)	Material	Invert Elev at main (m)	Invert Elev at property line (m)	Invert Elev at service end (m)	Distance into property (m)	Installation Date
Sanitary	100mm	AC	-	-	-	-	December 1957
Water	20mm	Copper	-	-	-	-	July 2017
Storm	N/A	N/A	-	-	-	-	

Service Connection Location				Sanitary (m)	Storm (m)
Distance from downstream San MH	1969	towards upstream San MH	2668	98.60	
Distance from downstream Stm MH	-	towards upstream Stm MH	-		

Power	Size	Communications	Size	Cable	Size	Gas	Size
BC Hydro	-	Telus	-	Shaw	-	FortisBC	-
Overhead Service		Overhead Service		Overhead Service			

Installed by:		Survey Date:	-
Comments:	New 20mm service replaced old 13mm water service		

**NOT TO SCALE** The information contained herein is for internal use only.  
Not to be relied on unless confirmed by site inspection and/or investigation.

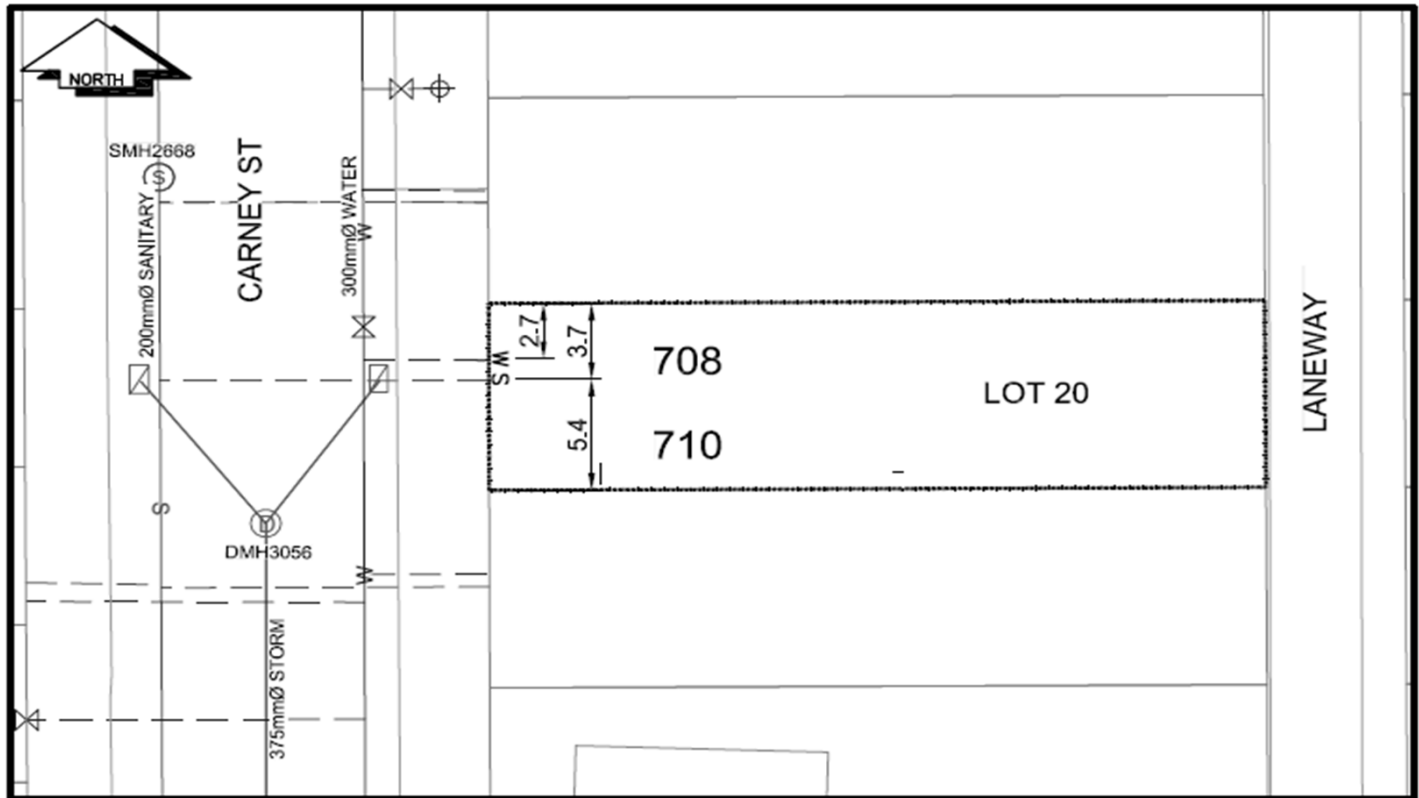

CS <sup>o</sup> CURB STOP	--- WATER SERVICE	--- STORM SERVICE
CO <sup>o</sup> CLEAN OUT	--- SANITARY SERVICE	--- G GAS
⊗ WATER VALVE	⊗ FIRE HYDRANT	--- ENCUMBRANCE

**NOT TO SCALE**