



City of Prince George History Sheet

| | |
|------|-------------|
| PID: | 9788751 |
| MU: | 101893 |
| WO: | 92871/92873 |

Civic Address: 700 702 Carney St

Legal Description: Lot: A Block: 75 District Lot: 343 Plan: 1268


| Service Type | Diameter (mm) | Material | Invert Elev at main (m) | Invert Elev at property line (m) | Invert Elev at service end (m) | Distance into property (m) | Installation Date |
|--------------|---------------|----------|-------------------------|----------------------------------|--------------------------------|----------------------------|-------------------|
| Sanitary | 100mm | PVC | - | - | - | - | July 2017 |
| Water | 20mm | Copper | - | - | - | - | July 2017 |
| Storm | N/A | N/A | - | - | - | - | |

| Service Connection Location | | | | Sanitary (m) | Storm (m) |
|---------------------------------|------|-------------------------|------|--------------|-----------|
| Distance from downstream San MH | 1969 | towards upstream San MH | 2668 | 107.14 | |
| Distance from downstream Stm MH | - | towards upstream Stm MH | - | | |

| Power | Size | Communications | Size | Cable | Size | Gas | Size |
|------------------|------|------------------|------|------------------|------|----------|------|
| BC Hydro | - | Telus | - | Shaw | - | FortisBC | - |
| Overhead Service | | Overhead Service | | Overhead Service | | | |

| | | | |
|---------------|------------------------------|--------------|---|
| Installed by: | City of Prince George forces | Survey Date: | - |
| Comments: | | | |
| | | | |
| | | | |

NOT TO SCALE The information contained herein is for internal use only.
Not to be relied on unless confirmed by site inspection and/or investigation.

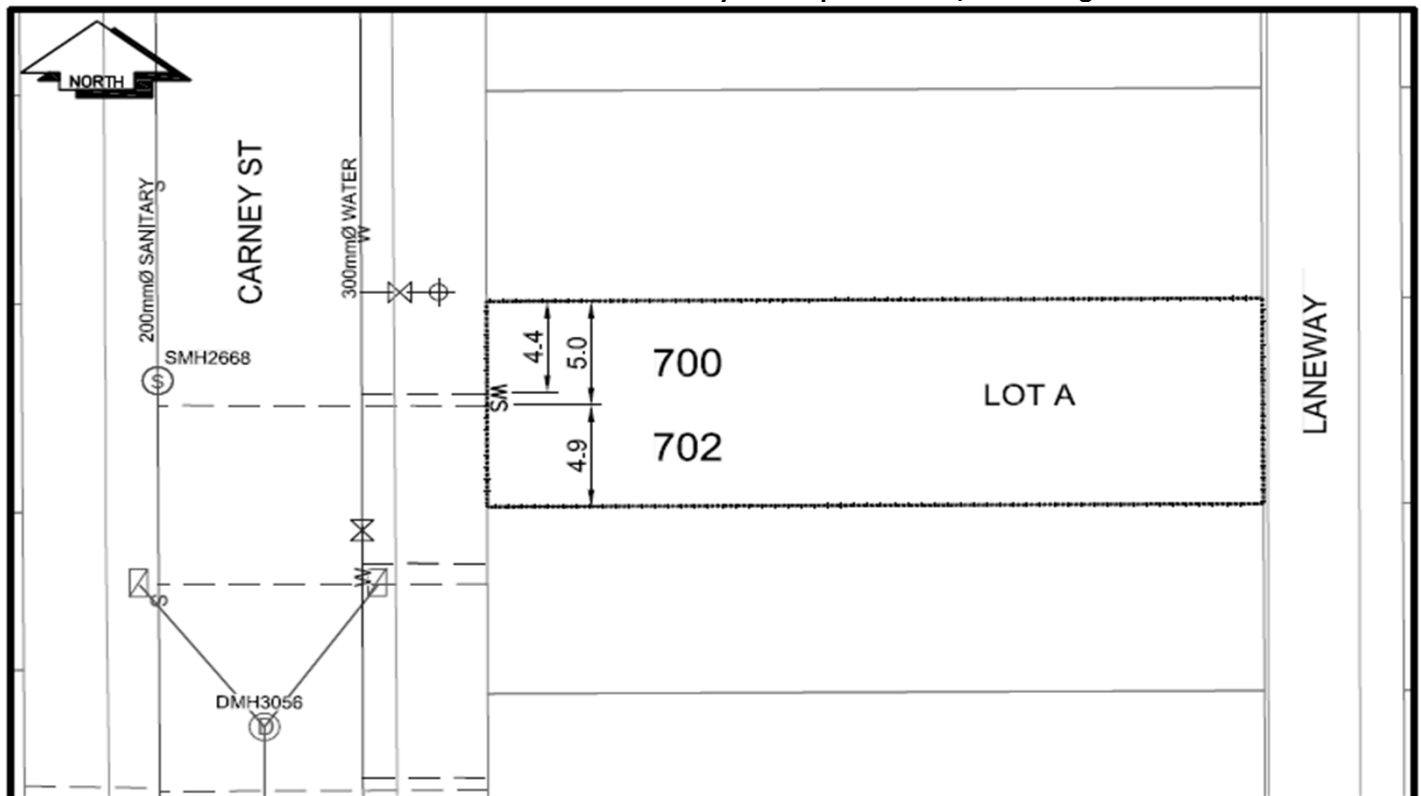

| | | |
|--------------|----------------------|-------------------|
| CS CURB STOP | --- WATER SERVICE | --- STORM SERVICE |
| CO CLEAN OUT | --- SANITARY SERVICE | --- GAS |
| WATER VALVE | --- FIRE HYDRANT | --- ENCUMBRANCE |

NOT TO SCALE