



# City of Prince George History Sheet

PID:	009789227
SD/MU:	
WO:	

Civic Address: 2575 Oak St

Legal Description: Lot: 3 District Lot: 943 Plan: 20937


Service Type	Diameter (mm)	Material	Invert Elev at main (m)	Invert Elev at property line (m)	Invert Elev at service end (m)	Distance into property (m)	Installation Date
Sanitary	100mm	AC	-	567.49	-	-	January 1972
Water	40mm	Copper	-	-	-	-	January 1972
Storm	N/A	N/A	-	-	-	-	

Service Connection Location	Sanitary (m)	Storm (m)
100mm Sanitary service connectrd to San MH2990 on Diefenbaker Dr	52.91	
Distance from downstream Stm MH - towards upstream Stm MH -		

Power	Size	Communications	Size	Cable	Size	Gas	Size
BC Hydro	-	Telus	-	Shaw	-	FortisBC	-
Overhead Service		Overhead Service		Overhead Service			

Installed by:	Survey Date:	-
Comments:		

**NOT TO SCALE** The information contained herein is for internal use only.  
Not to be relied on unless confirmed by site inspection and/or investigation.

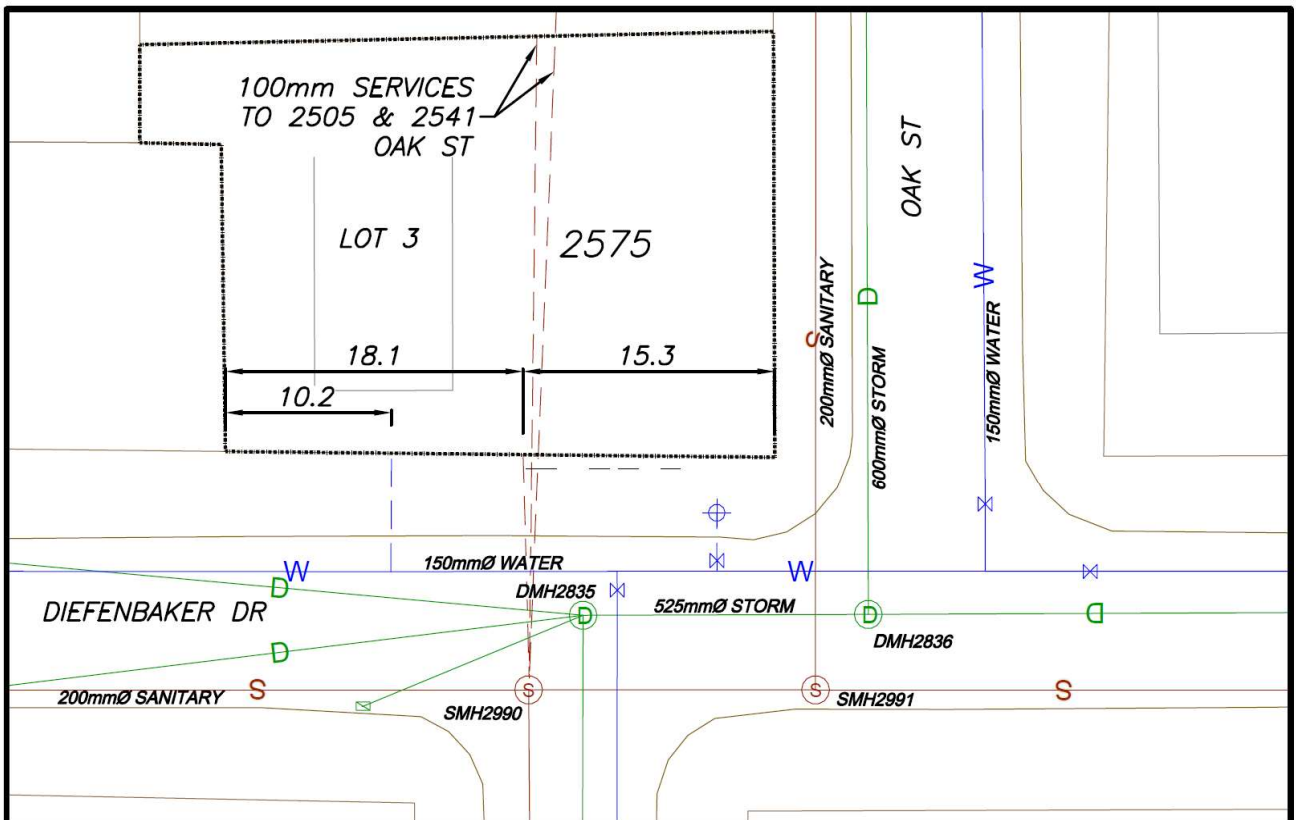

CS	CURB STOP	—	WATER SERVICE	—	STORM SERVICE
CO	CLEAN OUT	---	SANITARY SERVICE	—G—	GAS
WV	WATER VALVE	—X—	FIRE HYDRANT	---	ENCUMBERANCE

**NOT TO SCALE**