


# City of Prince George Lot History Sheet

PID	Civic Address	Lot	Block	Plan	DI	Free Legal
009809465	1901 VICTORIA ST	A		9637	343	
009809465	1945 VICTORIA ST	A		9637	343	
009809465	1915 VICTORIA ST	A		9637	343	
009809465	1955 VICTORIA ST	A		9637	343	
009809465	1961 VICTORIA ST	A		9637	343	
009809465	1925 VICTORIA ST	A		9637	343	
009809465	1935 VICTORIA ST	A		9637	343	

	Size (mm)	Material	Invert @ PL	Cut @ PL	Survey Date	Field Book	Location	Comments
Sanitary	100 mm	—					Conn # 1254	
	100 mm	ACS					5317	
	100 mm	ACS					3981	
Water	25 mm	—					Conn # 839	
	20 mm	cu					4318	
	20 mm	cu					835	
	50 mm	—						
Storm	150 mm	—					Conn # 202	

Accuracy Not Guaranteed Unless Confirmed By Site Inspection and/or Investigation.  
Sketch is Oriented North (NTS)

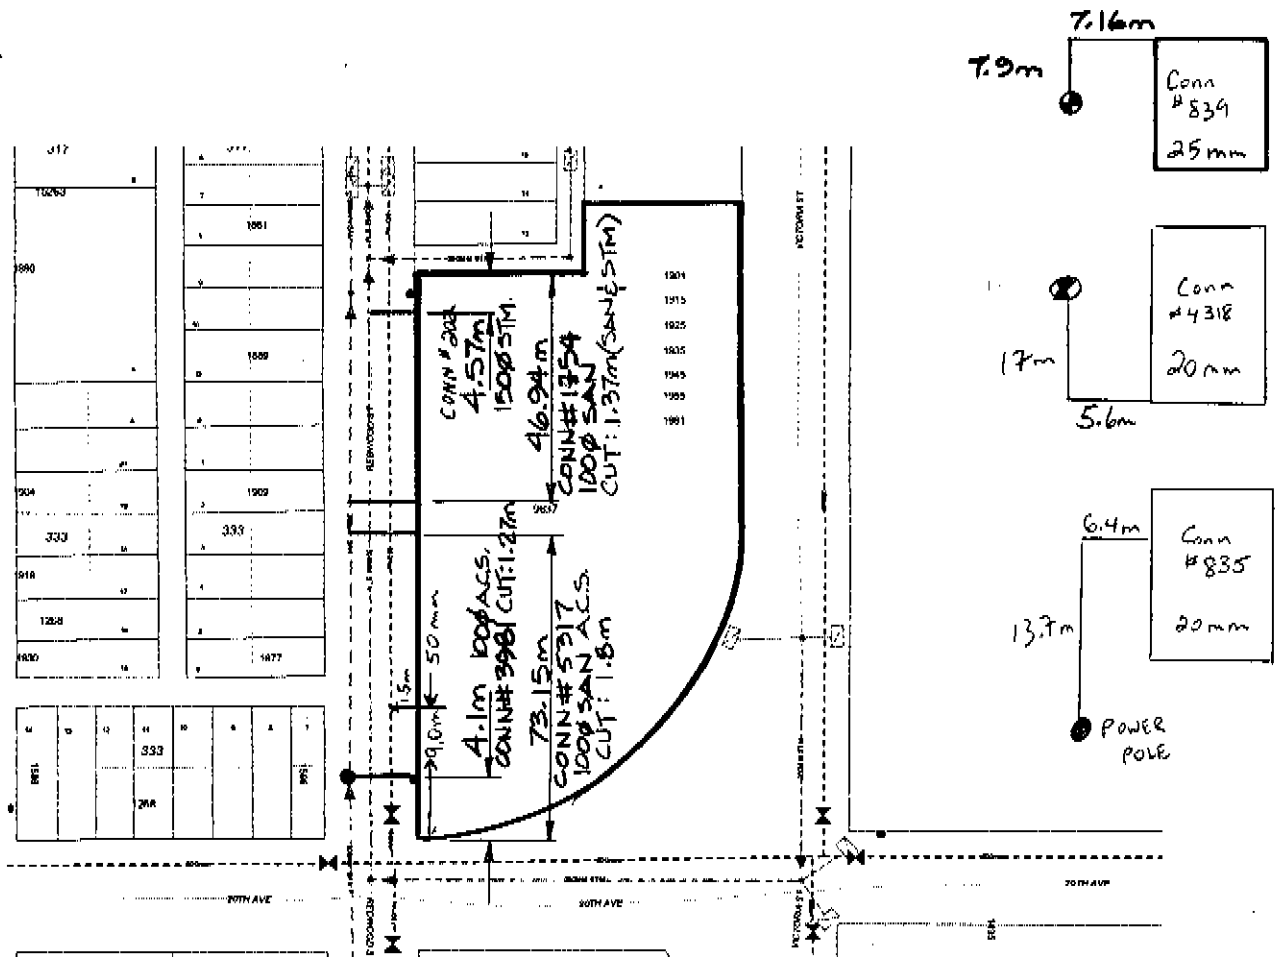

2" water service installed to  
1945 Victoria St in 2002  
for Shanghai Palace Restaurant  
MU100115 / WO 02-P001  
Location not recorded