

City of Prince George
HISTORY SHEET

SHEET NUMBER **7367** Roll Number **009812741**

Legal: LOT'S **22** BLOCK D.L. **2426** PLAN **20751**

Address: **4986 SOOKE RD.**

Sanitary Connection: # SIZE MATERIAL INV. CONNECTED

Water Connection # SIZE MATERIAL METER CONNECTED

Storm Connection: # SIZE MATERIAL INV. CONNECTED

Cash Receipt No's: WATER SANITARY STORM

CURB FROM PROPERTY LINE PAVEMENT WIDTH

B.C. HYDRO UNDERGROUND CONNECTION


B.C. TELEPHONE UNDERGROUND CONNECTION

INLAND GAS

Information Sheets:

Comments:

SITE PLAN N.T.S.

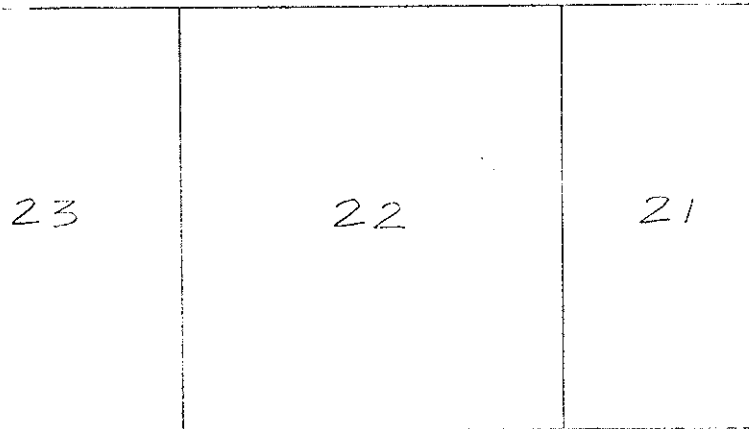

P/L

SOOKE RD.

P/L