

City of Prince George  
HISTORY SHEET

SHEET NUMBER **7409** Roll Number **009813802**

Legal: LOT'S **48** BLOCK D.L. **2426** PLAN **20751**

Address: **4850 BLAZER RD.**

Sanitary Connection: # SIZE MATERIAL INV. CONNECTED

Water Connection # SIZE MATERIAL METER CONNECTED

Storm Connection: # SIZE MATERIAL INV. CONNECTED

Cash Receipt No's: WATER SANITARY STORM

CURB FROM PROPERTY LINE PAVEMENT WIDTH

B.C. HYDRO UNDERGROUND CONNECTION


B.C. TELEPHONE UNDERGROUND CONNECTION

INLAND GAS

Information Sheets:

Comments:

SITE PLAN N.T.S.

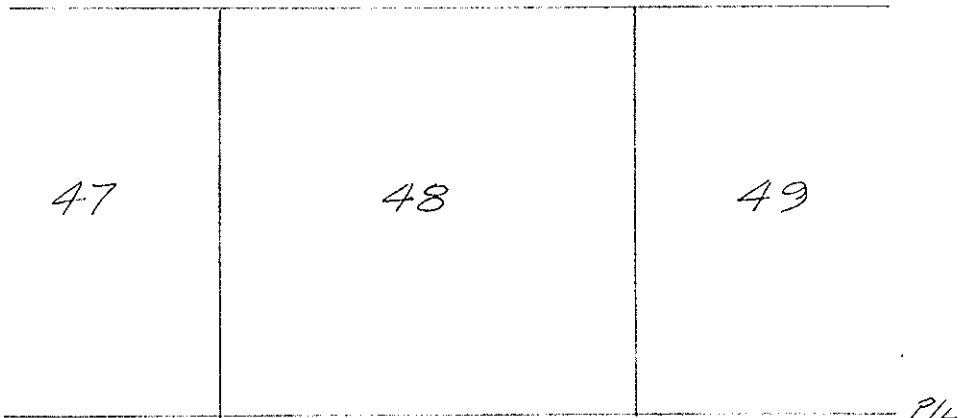

P/L

P/L

BLAZER RD.