



City of Prince George  
**History Sheet**

PID:	009880747
SD/MU:	
WO:	

Civic Address: 2555 Wallace Place


Legal Description: Lot: 32 District Lot: 4046 Plan: 23142

Service Type	Diameter	Material	Invert Elev at main	Invert Elev at property line	Invert Elev service end	Distance into property	Installation Date
Sanitary	100mm	PVC	763.22	-	763.54	-0.40	August 2014
Water	20mm	Copper	-	-	-	-	
Storm	N/A	N/A	-	-	-	-	

Service Connection Location				Sanitary	Storm
Distance from downstream San MH	5344	towards upstream San MH	5345	45.4m	
Distance from downstream Stm MH	-	towards upstream Stm MH	-		

Power	Size	Communications	Size	Cable	Size	Gas	Size
BC Hydro	-	Telus	-	Shaw	-	FortisBC	-
Overhead Service		Overhead Service		Overhead Service			

Installed by:	City of Prince George forces	Survey Date:	August 2014
---------------	------------------------------	--------------	-------------

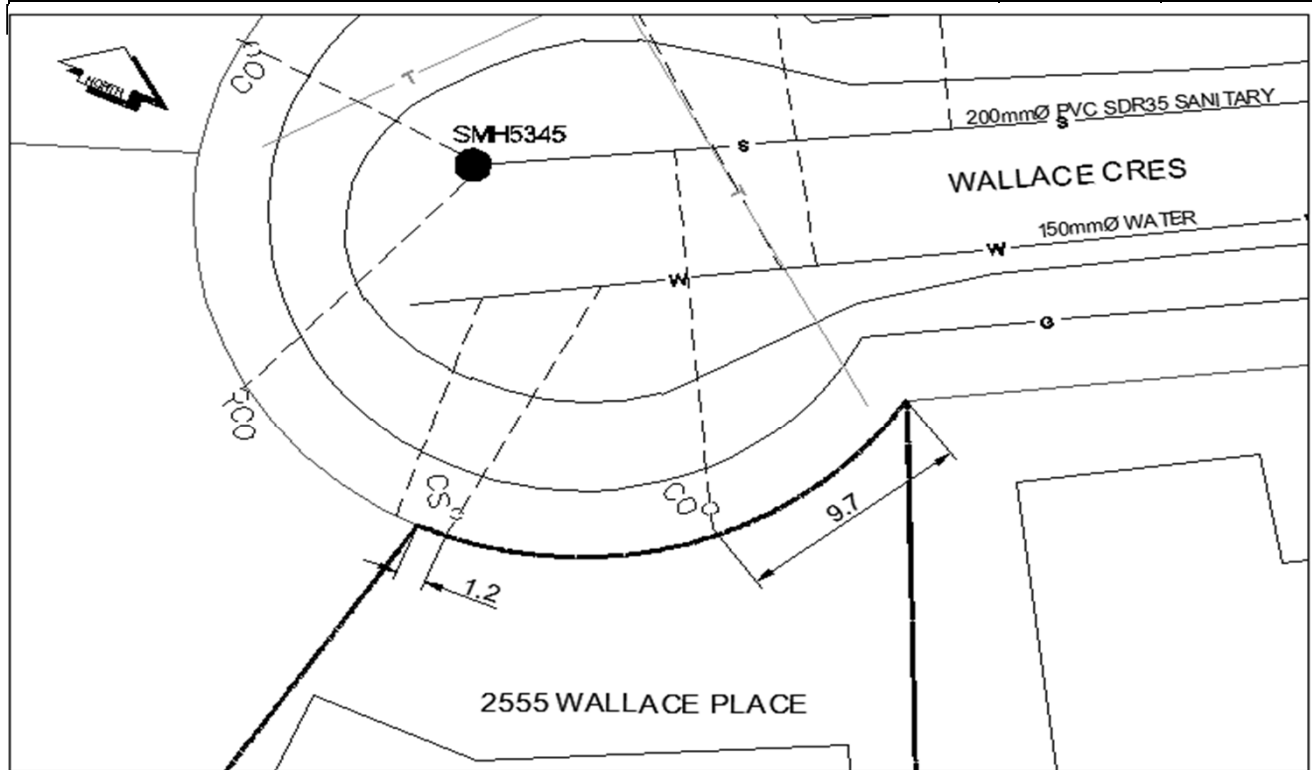

Legend:	CS <sup>o</sup> CURB STOP	--- WATER SERVICE	—G— GAS
	CO <sup>o</sup> CLEAN OUT	--- SANITARY SERVICE	—T— OVERHEAD POWER & COMMUNICATIONS

NOT TO SCALE