



City of Prince George History Sheet

| | |
|--------|-----------|
| PID: | 009881034 |
| SD/MU: | |
| WO: | |

Civic Address: 3088 Wallace Cres

Legal Description: Lot: 40 District Lot: 4046 Plan: 23142


| Service Type | Diameter | Material | Invert Elev at main | Invert Elev at property line | Invert Elev service end | Distance into property | Installation Date |
|--------------|----------|----------|---------------------|------------------------------|-------------------------|------------------------|-------------------|
| Sanitary | 100mm | PVC | 767.50 | - | 768.10 | -1.30 | August 2014 |
| Water | 20mm | Copper | - | - | - | - | |
| Storm | N/A | N/A | - | - | - | - | |

| Service Connection Location | | | | Sanitary | Storm |
|---------------------------------|------|-------------------------|------|----------|-------|
| Distance from downstream San MH | 5346 | towards upstream San MH | 5343 | 44.4m | |
| Distance from downstream Stm MH | - | towards upstream Stm MH | - | | |

| Power | Size | Communications | Size | Cable | Size | Gas | Size |
|------------------|------|------------------|------|------------------|------|----------|------|
| BC Hydro | - | Telus | - | Shaw | - | FortisBC | - |
| Overhead Service | | Overhead Service | | Overhead Service | | | |

| | | | |
|---------------|------------------------------|--------------|-------------|
| Installed by: | City of Prince George forces | Survey Date: | August 2014 |
| Comments: | | | |

NOT TO SCALE The information contained herein is for internal use only.
Not to be relied on unless confirmed by site inspection and/or investigation.

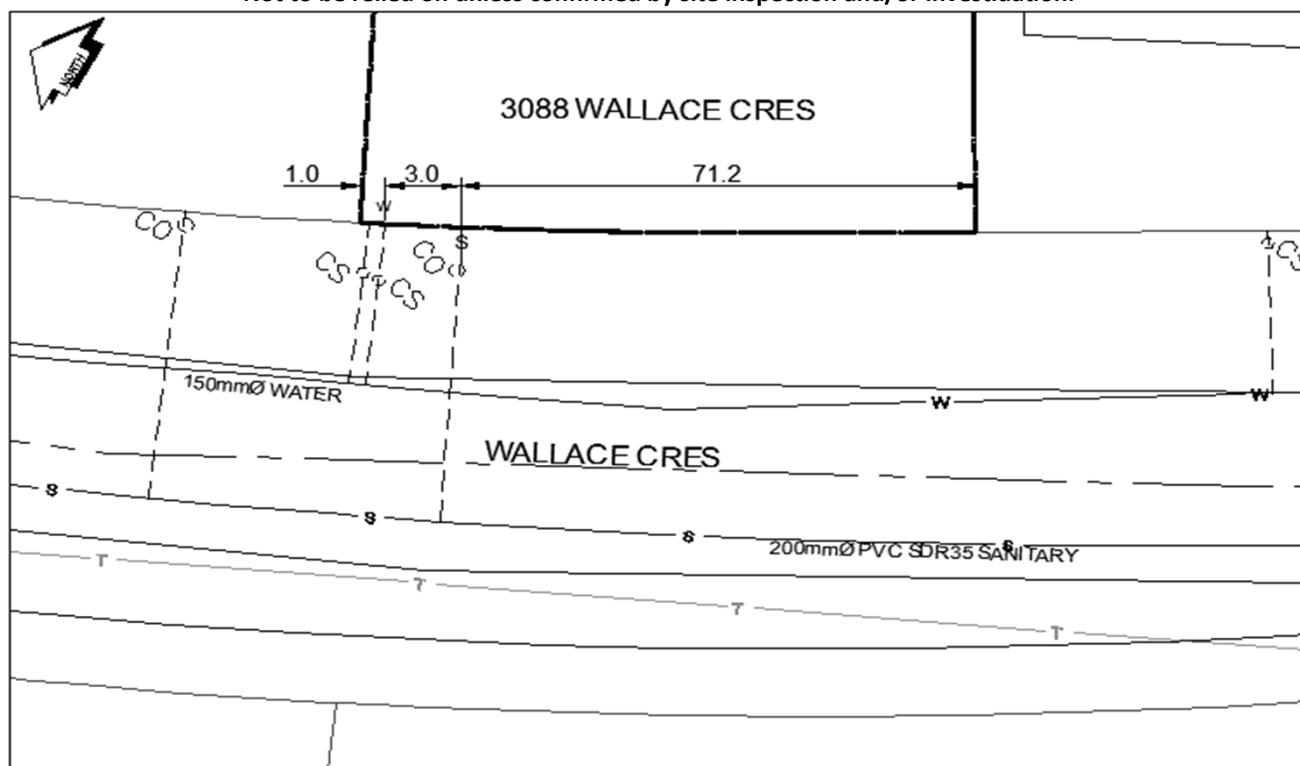

| | | | |
|---------|---------------------------|----------------------|---|
| Legend: | CS ^o CURB STOP | --- WATER SERVICE | —G— GAS |
| | CO ^o CLEAN OUT | --- SANITARY SERVICE | ---T--- OVERHEAD POWER & COMMUNICATIONS |

NOT TO SCALE