



# City of Prince George History Sheet

|        |           |
|--------|-----------|
| PID:   | 009881158 |
| SD/MU: |           |
| WO:    |           |

Civic Address: 3104 Wallace Cres

Legal Description: Lot: 44 District Lot: 4046 Plan: 23142


| Service Type | Diameter | Material | Invert Elev at main | Invert Elev at property line | Invert Elev service end | Distance into property | Installation Date |
|--------------|----------|----------|---------------------|------------------------------|-------------------------|------------------------|-------------------|
| Sanitary     | 100mm    | PVC      | 775.69              | 777.74                       | 777.74                  | 0.00                   | August 2014       |
| Water        | 20mm     | Copper   | -                   | -                            | -                       | -                      |                   |
| Storm        | N/A      | N/A      | -                   | -                            | -                       | -                      |                   |

| Service Connection Location     |      |                         |      | Sanitary | Storm |
|---------------------------------|------|-------------------------|------|----------|-------|
| Distance from downstream San MH | 5343 | towards upstream San MH | 5342 | 15.6m    |       |
| Distance from downstream Stm MH | -    | towards upstream Stm MH | -    |          |       |

| Power            | Size | Communications   | Size | Cable            | Size | Gas      | Size |
|------------------|------|------------------|------|------------------|------|----------|------|
| BC Hydro         | -    | Telus            | -    | Shaw             | -    | FortisBC | -    |
| Overhead Service |      | Overhead Service |      | Overhead Service |      |          |      |

|               |                              |              |             |
|---------------|------------------------------|--------------|-------------|
| Installed by: | City of Prince George forces | Survey Date: | August 2014 |
| Comments:     |                              |              |             |

**NOT TO SCALE** The information contained herein is for internal use only.  
Not to be relied on unless confirmed by site inspection and/or investigation.

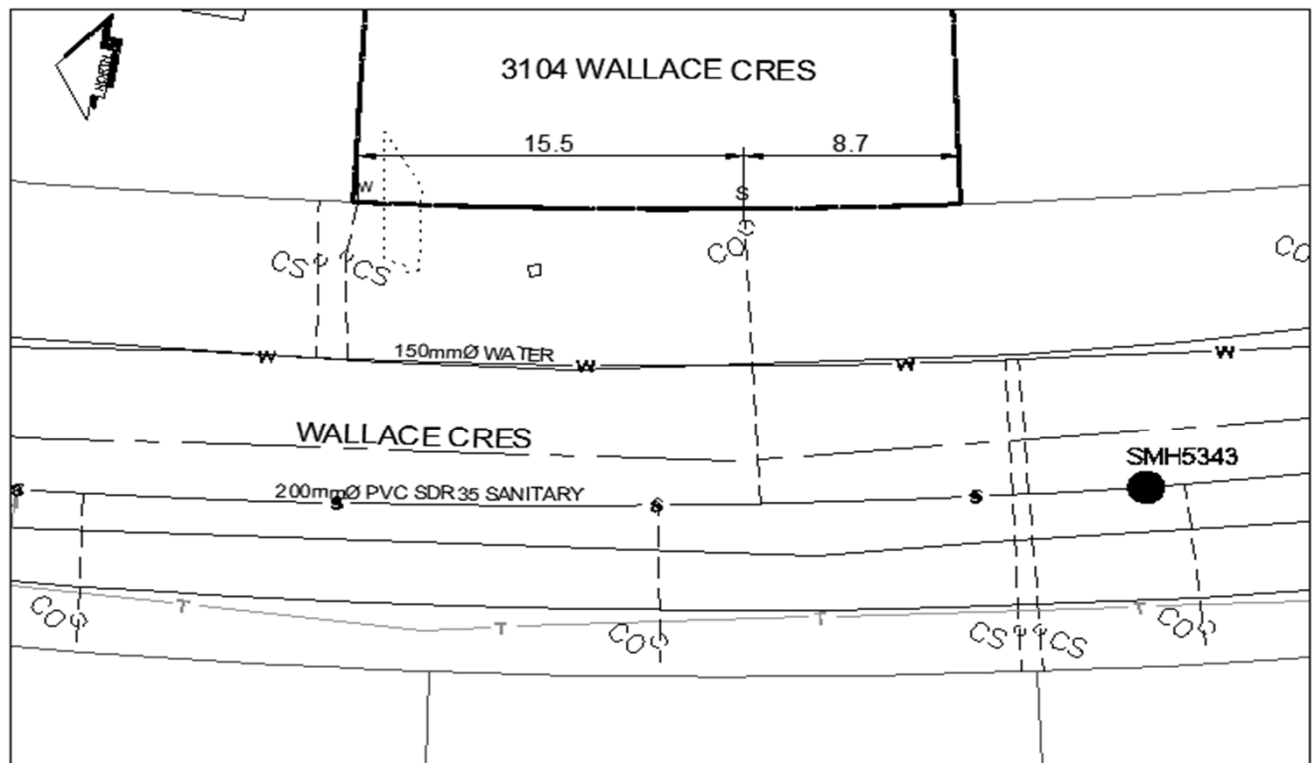

|         |                           |                      |                                   |
|---------|---------------------------|----------------------|-----------------------------------|
| Legend: | CS <sup>o</sup> CURB STOP | --- WATER SERVICE    | G GAS                             |
|         | CO <sup>o</sup> CLEAN OUT | --- SANITARY SERVICE | T OVERHEAD POWER & COMMUNICATIONS |

**NOT TO SCALE**