

City of Prince George
HISTORY SHEET

009939229

SHEET NUMBER **11188** Roll Number

Legal: LOT'S **27** BLOCK D.L. **4040** PLAN **20574**

Address: **2051 WOODHAVEN DR.**

Sanitary Connection: # **12136** SIZE **4"** MATERIAL **A.C.** INV. CONNECTED

Water Connection # **11298** SIZE **3/4"** MATERIAL **Copper** METER CONNECTED

Storm Connection: # SIZE MATERIAL INV. CONNECTED

Cash Receipt No's: WATER SANITARY STORM

CURB FROM PROPERTY LINE PAVEMENT WIDTH


B.C. HYDRO **OH.** UNDERGROUND CONNECTION

B.C. TELEPHONE **OH.** UNDERGROUND CONNECTION

INLAND GAS

Information Sheets:

Comments: The information contained herein is for internal use only. Not to be relied upon unless confirmed by site inspection and/or investigation.

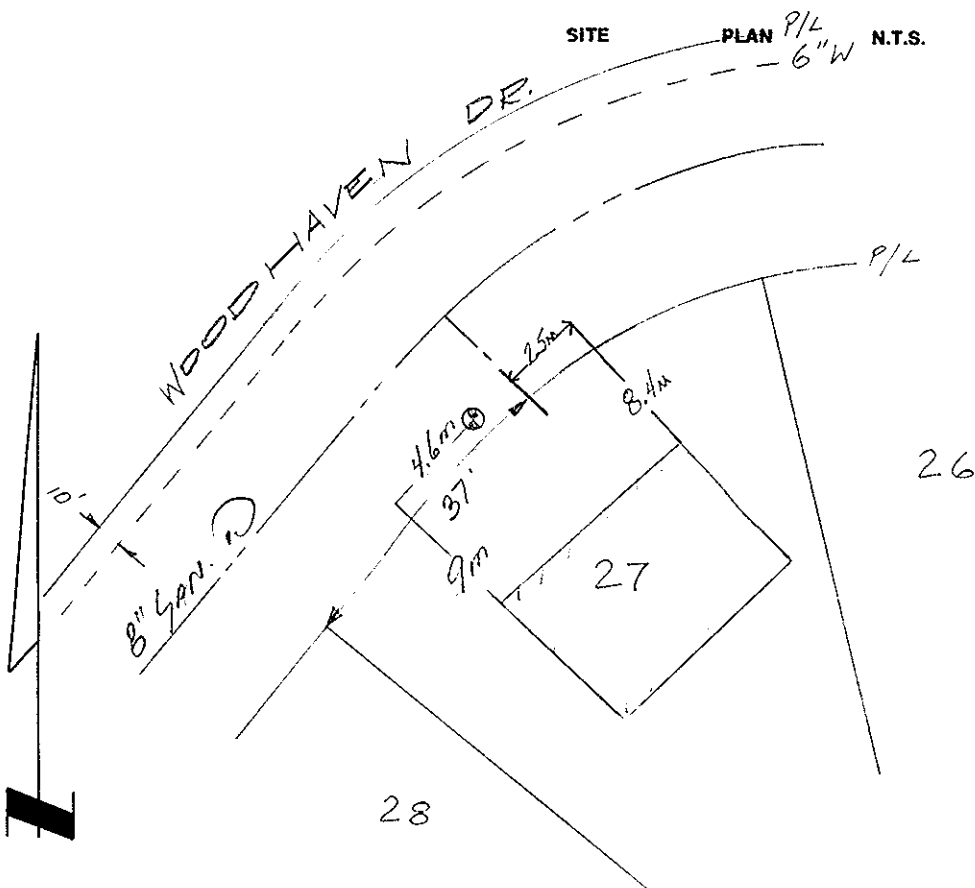

SANITARY & STORM INVERT CALCULATIONS

SANITARY

STORM

1. Distance from M.H. to connection point is ft. toward M.H.
2. Calculated invert of main to conn. pt. is
3. Main Size at connection point is Ins.
4. Conn. invert at half diameter (Crown) of main is
5. Add to (4) allowance of 0.2 for 1/8 bend. Adjusted invert now
6. Dist. from main to P/L equals ft. at in/ft gives rise of
7. Item (5) plus (6) equals Calculated Elev. of conn. inv. at P/L equals
13. Elev. of ref. hub top
14. Elev. of invert at P/line
15. Difference or cut below at property line
16. Survey Date JUNE 19 77 Book Ref. 373-61 by V.G.
17. Cut at P/Line in feet and inches 8'

39.78

16.
8'

Sanitary History:

FOR CONSTRUCTION JUNE 1/79

JULY 3/79 INSTALLED -

Water History:

CONN INSTALLED SEPT. 26, 1977.

FEB. 9/79 - TURN ON REQ BY: (doesn't say).

SEP 83 - LOC BY T. Pinko

Storm History: