



City of Prince George History Sheet

PID:	009983074
SD/MU:	
WO:	

Civic Address: 1559 Buchanan Ave

Legal Description: Lot: 5 District Lot: 913 Plan: 20389


Service Type	Diameter (mm)	Material	Invert Elev at main (m)	Invert Elev at property line (m)	Invert Elev at service end (m)	Distance into property (m)	Installation Date
Sanitary	100mm	AC	-	585.09	-	-	January 1972
Water	20mm	Copper	-	-	-	-	January 1972
Storm	N/A	N/A	-	-	-	-	

Service Connection Location	Sanitary (m)	Storm (m)
100mm Sanitary service connected to San MH 2051	-	
Distance from downstream Stm MH - towards upstream Stm MH -		

Power	Size	Communications	Size	Cable	Size	Gas	Size
BC Hydro	-	Telus	-	Shaw	-	FortisBC	-
Overhead Service		Overhead Service		Overhead Service			

Installed by:	Survey Date:	-
Comments: Water as per 2016 locate		
-		

NOT TO SCALE The information contained herein is for internal use only.
Not to be relied on unless confirmed by site inspection and/or investigation.

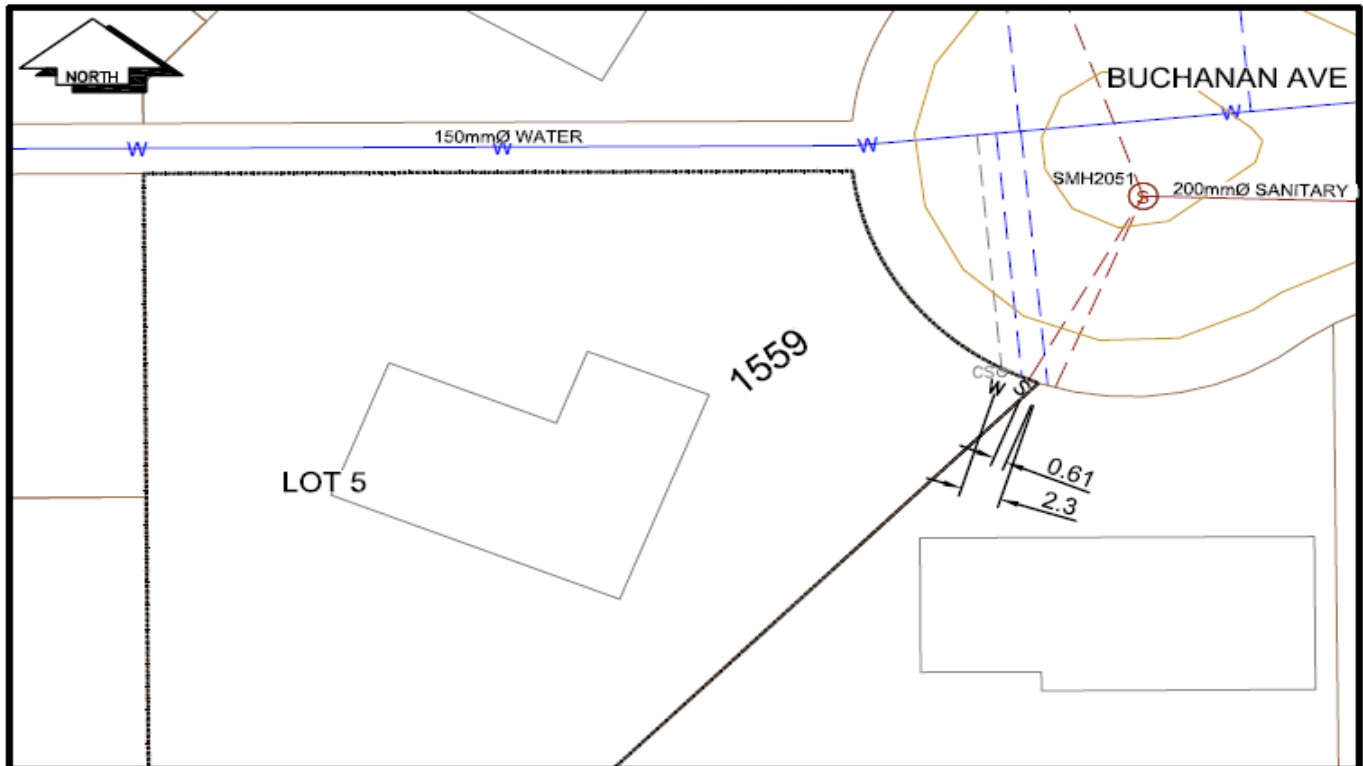

CS CURB STOP	--- WATER SERVICE	--- STORM SERVICE
CO CLEAN OUT	--- SANITARY SERVICE	--- GAS
W VALVE	--- FIRE HYDRANT	--- ENCUMBRANCE

NOT TO SCALE