



# City of Prince George History Sheet

PID:	009998624
SD/MU:	
WO:	

Civic Address: 2015, 2017, 2019 Oak St

Legal Description: Lot: 23, 24, 25 Block: 3 District Lot: 932 Plan: 796


Service Type	Diameter (mm)	Material	Invert Elev at main (m)	Invert Elev at property line (m)	Invert Elev at service end (m)	Distance into property (m)	Installation Date
Sanitary - north	100mm	AC	-	-	-	-	December 1969
Sanitary - south	100mm	AC	-	-	-	-	December 1969
Water - north	20mm	Copper	-	-	-	-	December 1969
Water - south	20mm	Copper	-	-	-	-	December 1969
Storm	N/A	N/A	-	-	-	-	

Service Connection Location				Sanitary (m)	Storm (m)
Distance from downstream San MH	3389	towards upstream San MH	3294	16.48	
Distance from downstream San MH	3389	towards upstream San MH	3294	18.95	

Power	Size	Communications	Size	Cable	Size	Gas	Size
BC Hydro	-	Telus	-	Shaw	-	FortisBC	-
Overhead Service		Overhead Service		Overhead Service			

Installed by:		Survey Date:	-
Comments:	Water and Sanitary services confined August 31, 2018		

**NOT TO SCALE** The information contained herein is for internal use only.  
Not to be relied on unless confirmed by site inspection and/or investigation.

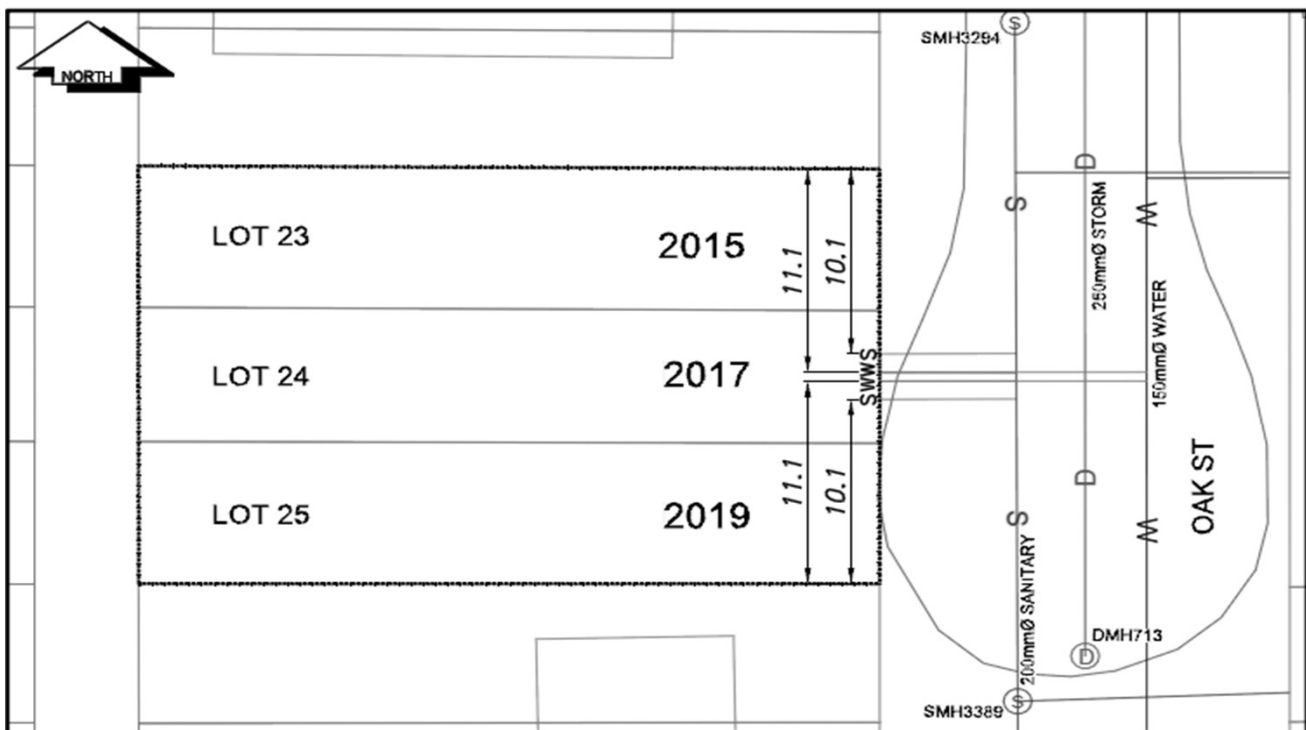

CS <sup>o</sup> CURB STOP	— WATER SERVICE	— STORM SERVICE
CO <sup>o</sup> CLEAN OUT	— SANITARY SERVICE	— GAS
⊗ WATER VALVE	⊗ FIRE HYDRANT	— ENCUMBRANCE

NOT TO SCALE