

City of Prince George HISTORY SHEET

010 006 133

SHEET NUMBER

Roll Number

013425 765

Legal: LOT'S 7-8 BLOCK 55 D.L. 937 PLAN 752

Address: 445 HARPER ST.

Sanitary Connection: # 1805 SIZE 100 mm MATERIAL A.C. INV. CONNECTED

Water Connection # 3038 SIZE 20 mm MATERIAL CU. METER CONNECTED

Storm Connection: # SIZE MATERIAL INV. CONNECTED

Cash Receipt No's: WATER SANITARY STORM

CURB FROM PROPERTY LINE 4.877 m PAVEMENT WIDTH 10.363 m

B.C. HYDRO 0/H UNDERGROUND CONNECTION


B.C. TELEPHONE 0/H UNDERGROUND CONNECTION

INLAND GAS AS SHOWN

Information Sheets:

Comments: WITH THAW WIRE.

**THE INFORMATION CONTAINED HEREIN IS FOR INTERNAL USE ONLY.
NOT TO BE RELIED UPON UNLESS CONFIRMED BY SITE INSPECTION AND/OR INVESTIGATION**

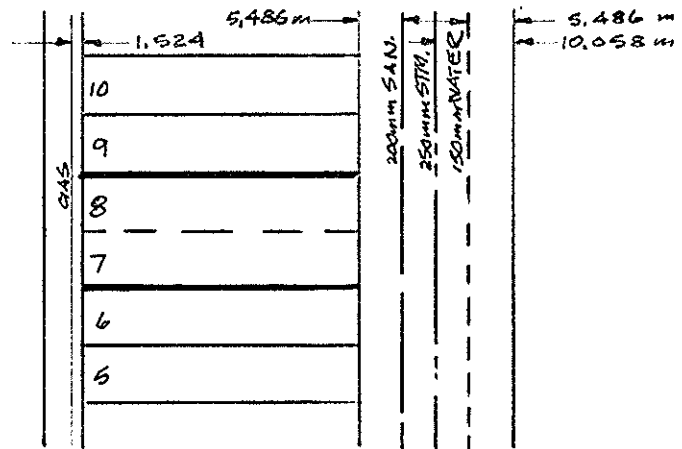

HARPER ST.