



City of Prince George History Sheet

PID:	010021779
SD/MU:	
WO:	

Civic Address: 2947 Nicole Ave

Legal Description: Lot: 44 District Lot: 8177 Plan: 20375


Service Type	Diameter (mm)	Material	Invert Elev at main (m)	Invert Elev at property line (m)	Invert Elev at service end (m)	Distance into property (m)	Installation Date
Sanitary	100mm	AC	-	-	-	-	January 1972
Water	20mm	Copper	-	-	-	-	January 1972
Storm	N/A	N/A	-	-	-	-	

Service Connection Location				Sanitary (m)	Storm (m)
Distance from downstream San MH	1785	towards upstream San MH	1772	34.44	
Distance from downstream Stm MH	-	towards upstream Stm MH	-		

Power	Size	Communications	Size	Cable	Size	Gas	Size
BC Hydro	-	Telus	-	Shaw	-	FortisBC	-
Underground Service		Underground Service		Underground Service			

Installed by:	Survey Date:	-
Comments:		

NOT TO SCALE The information contained herein is for internal use only.
Not to be relied on unless confirmed by site inspection and/or investigation.

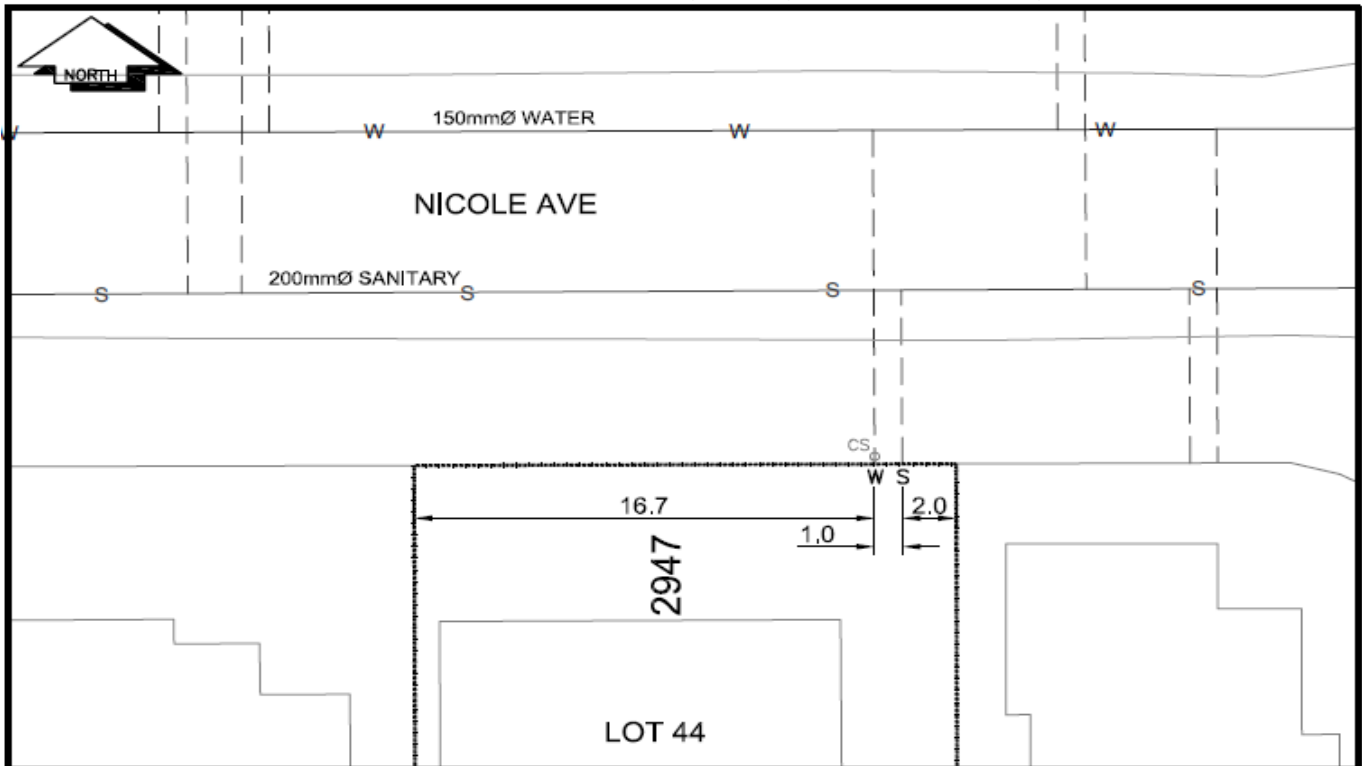

LEGEND:	CS ^o CURB STOP	--- W WATER SERVICE	--- S STORM SERVICE
	CO ^o CLEAN OUT	--- S SANITARY SERVICE	--- G GAS

NOT TO SCALE