



City of Prince George  
**History Sheet**

PID:	010072314
SD/MU:	
WO:	

Civic Address: 1037 Limestone Cres

Legal Description: Lot: 152 District Lot: 2507 Plan: 20259


Service Type	Diameter (mm)	Material	Invert Elev at main (m)	Invert Elev at property line (m)	Invert Elev at service end (m)	Distance into property (m)	Installation Date
Sanitary	100mm	PVC	-	603.93	-	-	December 1971
Water	20mm	Copper	-	-	-	-	December 1972
Storm	N/A	N/A	-	-	-	-	

Service Connection Location				Sanitary (m)	Storm (m)
Distance from downstream San MH	2032	towards upstream San MH	2028	53.66	
Distance from downstream Stm MH	-	towards upstream Stm MH	-		

Power	Size	Communications	Size	Cable	Size	Gas	Size
BC Hydro	-	Telus	-	Shaw	-	FortisBC	-
Underground Service		Underground Service		Underground Service			

Installed by:	Survey Date:	-
Comments:	Water and Sanitary services confirmed November 2013	

**NOT TO SCALE** The information contained herein is for internal use only.  
Not to be relied on unless confirmed by site inspection and/or investigation.

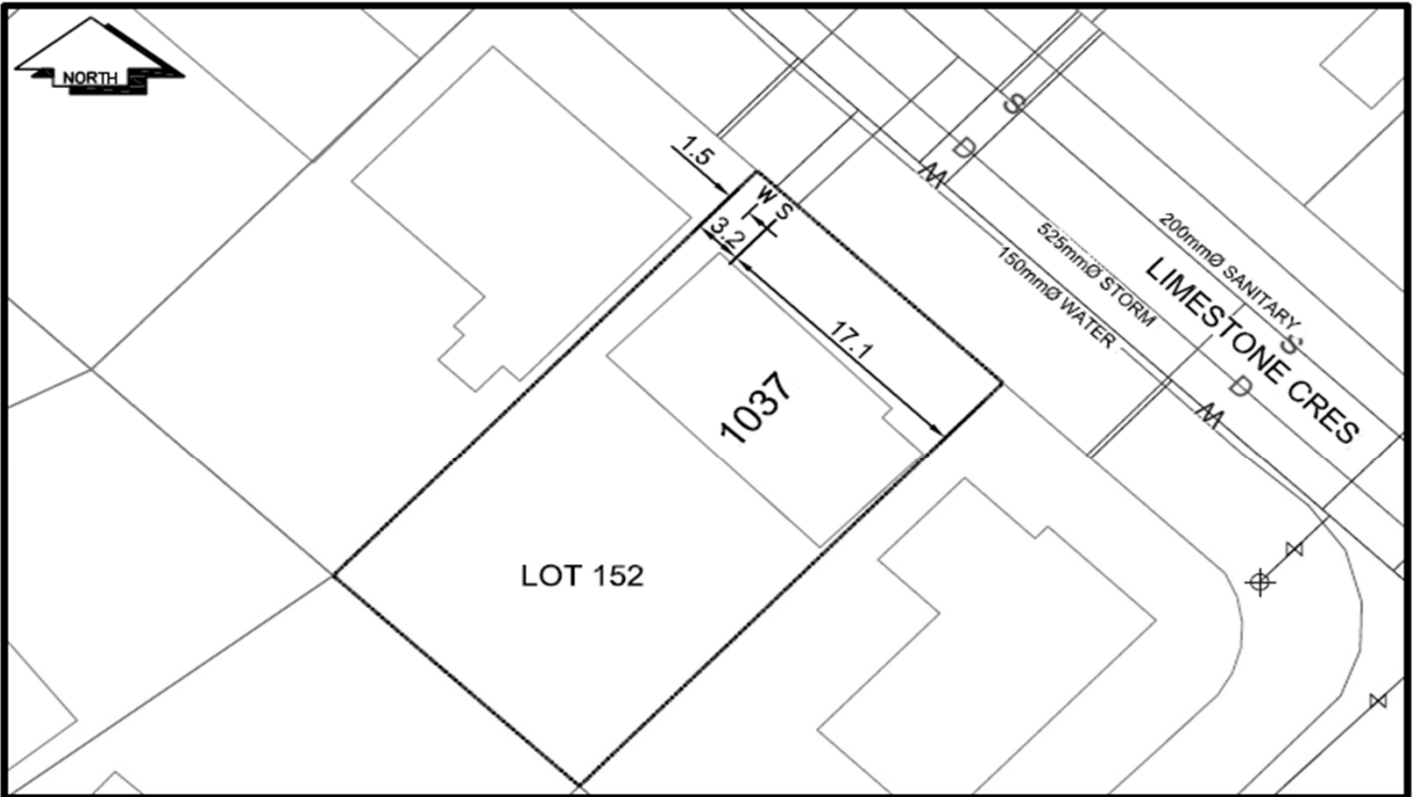

CS <sup>o</sup> CURB STOP	—X— WATER SERVICE	—o— STORM SERVICE
CO <sup>o</sup> CLEAN OUT	- - - - - SANITARY SERVICE	—G— GAS
⊗ WATER VALVE	⊗ FIRE HYDRANT	- - - - - ENCUMBRANCE

**NOT TO SCALE**