

City of Prince George HISTORY SHEET

FL

SHEET NUMBER

Roll Number

Legal: LOT'S 149 BLOCK 2507 PLAN 20259

Address: 1003 NELSON CRES.

Sanitary Connection: # 8239 SIZE 100mm MATERIAL AC INV. CONNECTED

Water Connection # 8239 SIZE 3/4" MATERIAL BID TUBE METER CONNECTED 1972

Storm Connection: # SIZE MATERIAL INV. CONNECTED

Cash Receipt No's: WATER SANITARY STORM

CURB FROM PROPERTY LINE PAVEMENT WIDTH

B.C. HYDRO UNDERGROUND CONNECTION



B.C. TELEPHONE UNDERGROUND CONNECTION

INLAND GAS

Information Sheets:

Comments:

**THE INFORMATION CONTAINED HEREIN IS FOR INTERNAL USE ONLY.
NOT TO BE RELIED UPON UNLESS CONFIRMED BY SITE INSPECTION AND/OR INVESTIGATION**

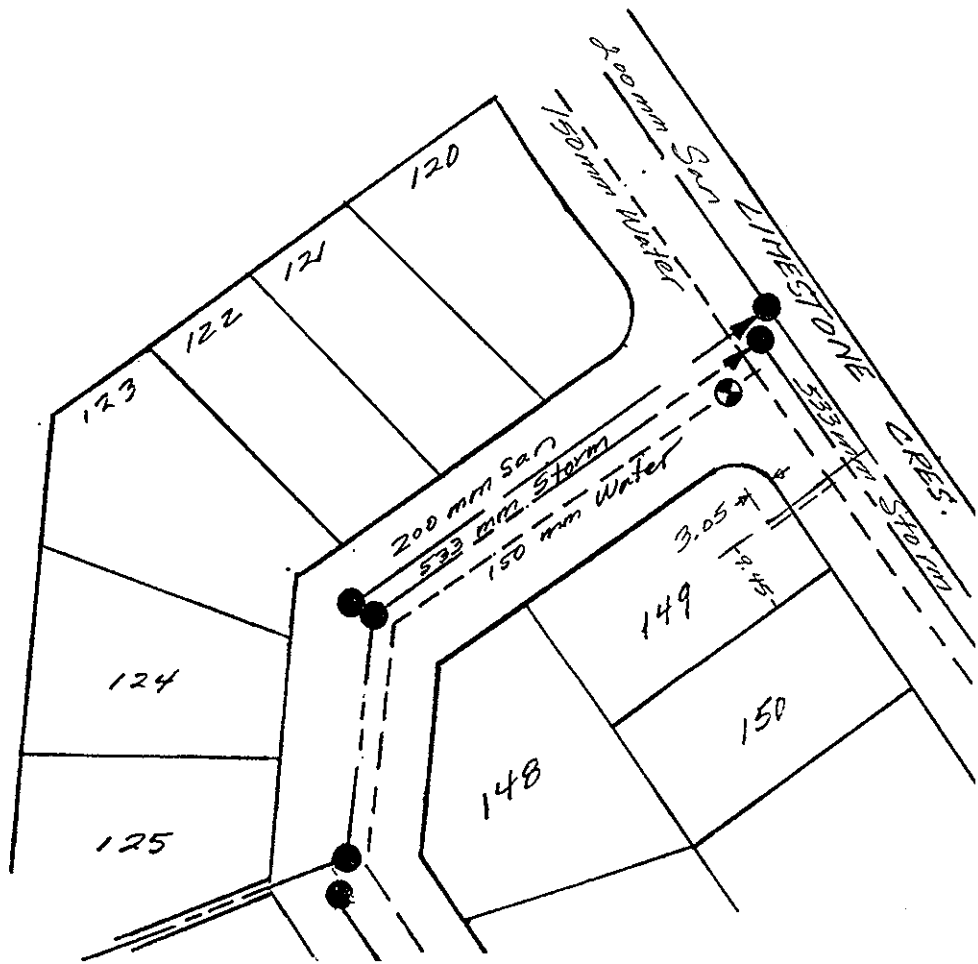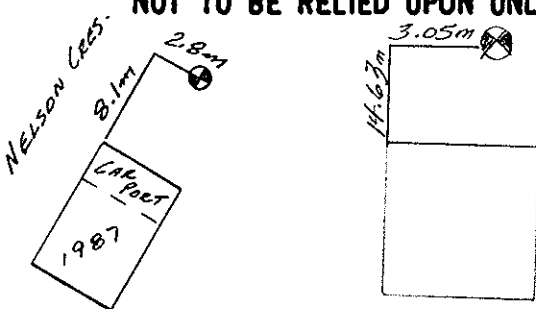

FOOTING