



City of Prince George History Sheet

PID:	010079408
SD/MU:	
WO:	

Civic Address: 1111 Tabor Blvd

Legal Description: Lot: 43 District Lot: 2507 Plan: 20259


Service Type	Diameter (mm)	Material	Invert Elev at main (m)	Invert Elev at property line (m)	Invert Elev at service end (m)	Distance into property (m)	Installation Date
Sanitary	100mm	AC	-	603.90	-	-	January 1972
Water	20mm	Copper	-	-	-	-	January 1972
Storm	N/A	N/A	-	-	-	-	

Service Connection Location	Sanitary (m)	Storm (m)
100mm Sanitary service connected to San MH 2776	-	
Distance from downstream Stm MH - towards upstream Stm MH -		

Power	Size	Communications	Size	Cable	Size	Gas	Size
BC Hydro	-	Telus	-	Shaw	-	FortisBC	-
Underground Service		Underground Service		Underground Service			

Installed by:	Survey Date:	-
Comments:		

NOT TO SCALE The information contained herein is for internal use only.
Not to be relied on unless confirmed by site inspection and/or investigation.

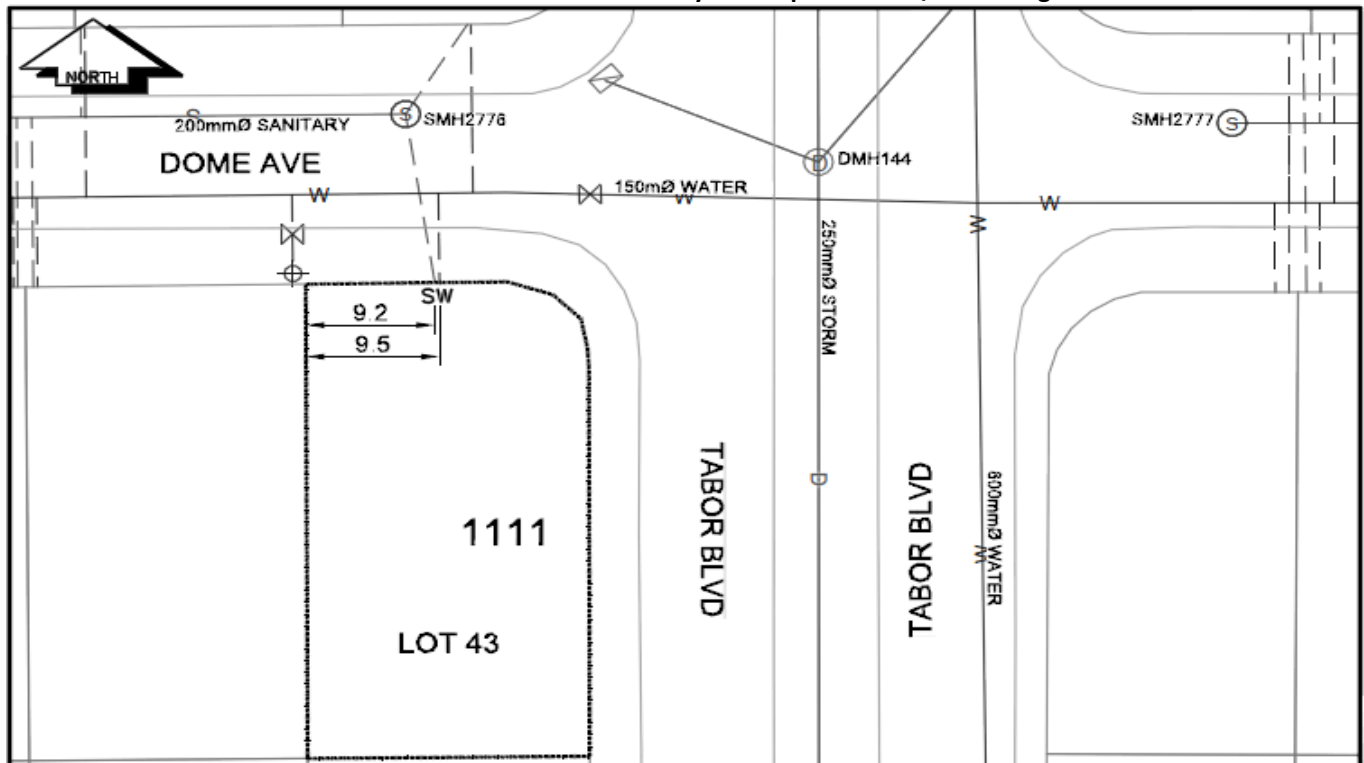

CS CURB STOP	--- W WATER SERVICE	--- S SANITARY SERVICE	--- G GAS
CO CLEAN OUT	--- S SANITARY SERVICE	--- G GAS	--- ENCUMBRANCE
WV WATER VALVE	--- F FIRE HYDRANT		

NOT TO SCALE