


Lot Servicing

2294 QUEENSWAY

PID: 010082905

Lot: 5, Block: 26, Plan: 1409, DL: 417

SERVICE	SIZE	MATERIAL	INSTALLED DATE	LOCATION	DETAILS
WATER	UNKNOWN	UNKNOWN			
SANITARY	100MM	AC		8.839M N OF SW COR PL	DIFF OR CUT BELOW @ P/L 2.743M
STORM	100MM	PVC	17-Oct-2005	INTO MH AT CORNER OF QUEENSWAY & QUADRANT CR	CONNECTION # 23131

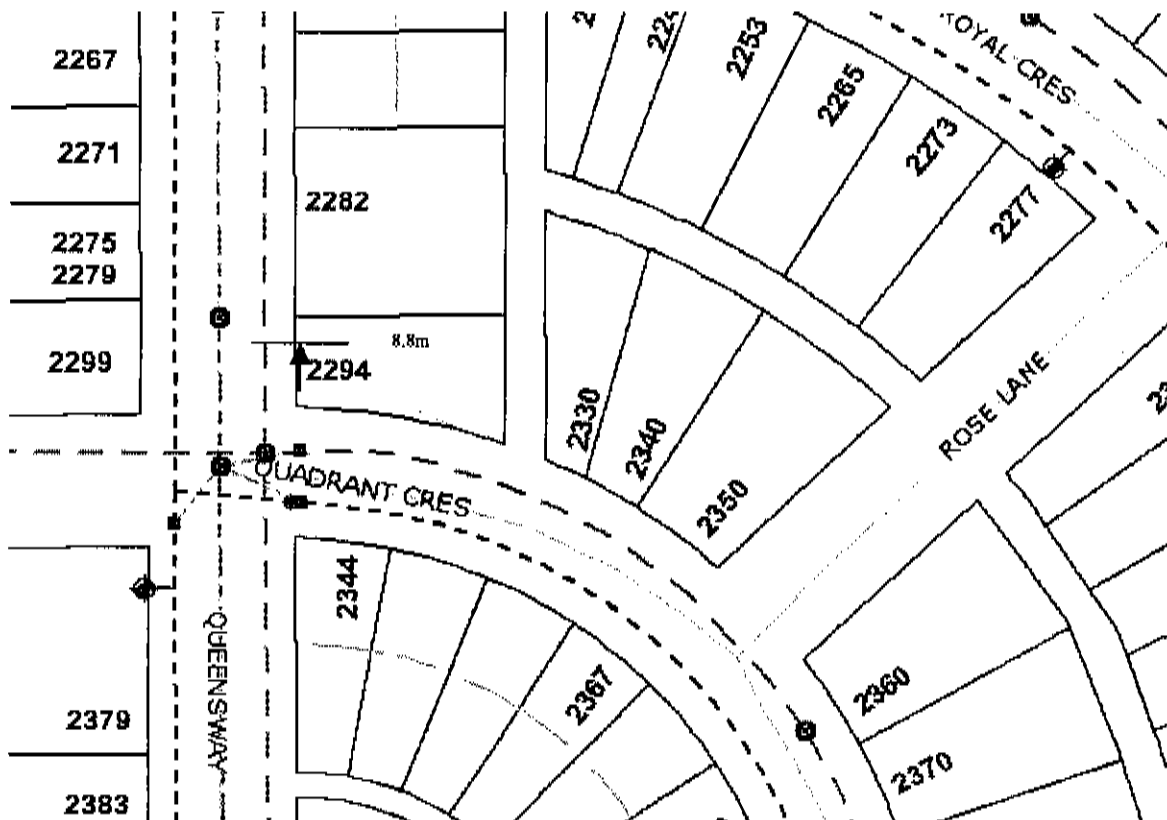

Accuracy not guaranteed unless confirmed by site inspection and/or investigation.
Connection location between main and property line only.