City of Prince George HISTORY SHEET


Roll Number 010095110 SHEET NUMBER D.L. 753 PLAN 20275 LOT'S REUS LOT A Legal: BLOCK Address: 3041-3056146 6166 CKES. Sanitary Connection: # 4.6. SIZE /SOMM MATERIAL CONNECTED **Water Connection** AC 100 MATERIAL METER CONNECTED 200mm MATERIAL **Storm Connection:** INV. CONNECTED Cash Receipt No's: STORM 05/6 WATER SANITARY PAVEMENT WIDTH CURB FROM PROPERTY LINE UNDERGROUND CONNECTION B.C. HYDRO UNDERGROUND CONNECTION **B.C. TELEPHONE** INLAND GAS

THE INFORMATION CONTAINED HEREIN IS FOR INTERNAL USE ONLY.

NOT TO BE RELIED UPON UNLESS CONFIRMED BY SITE INSPECTION AND/OR INVESTIGATION

Information Sheets:

Comments:

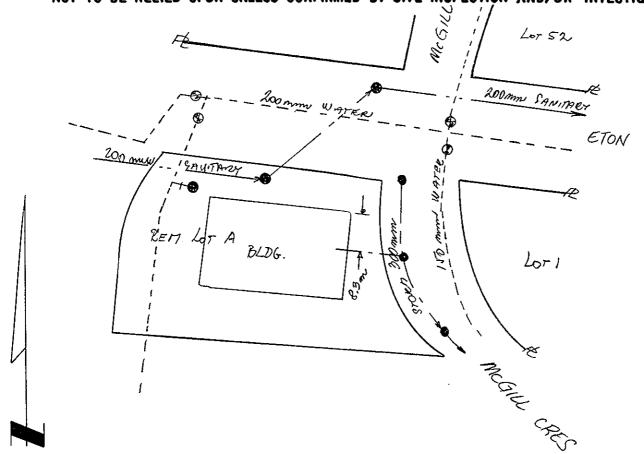

5