

# City of Prince George HISTORY SHEET

SHEET NUMBER

Roll Number 010120653

Legal:

LOT'S 16

BLOCK

D.L. 925

PLAN 16674

Address:

321 WILLIAMS CRES.

Sanitary Connection: #

5588

SIZE 100 mm MATERIAL A.C. INV.

CONNECTED

Water Connection #

5588

SIZE 20 mm MATERIAL C.U. METER

CONNECTED

Storm Connection: #

SIZE

MATERIAL

INV.

CONNECTED

Cash Receipt No's:

WATER

SANITARY

STORM

CURB FROM PROPERTY LINE

4.877 m

PAVEMENT WIDTH 10.363 m

B.C. HYDRO

O/H

UNDERGROUND CONNECTION

B.C. TELEPHONE

O/H

UNDERGROUND CONNECTION

INLAND GAS

AS SHOWN



Information Sheets:

Comments:

WITH THAW WIRE

THE INFORMATION CONTAINED HEREIN IS FOR INTERNAL USE ONLY.

NOT TO BE RELIED UPON UNLESS CONFIRMED BY SITE INSPECTION AND/OR INVESTIGATION

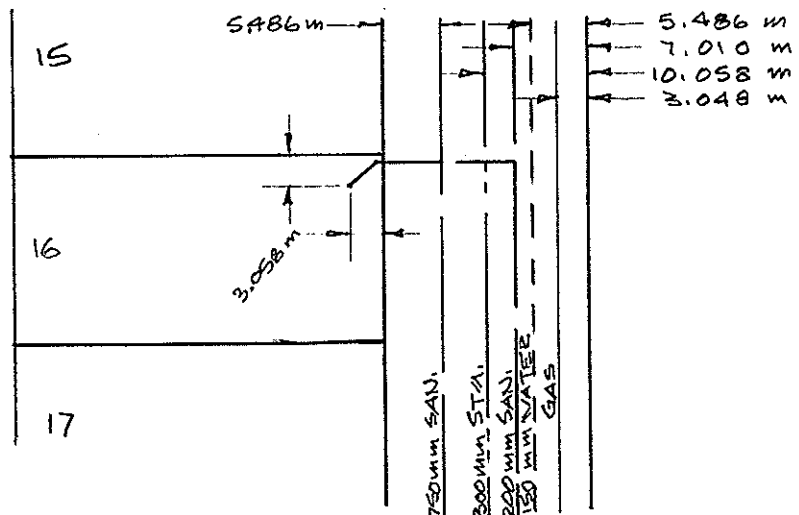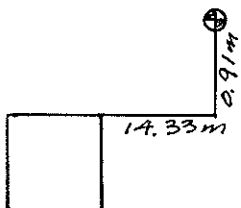

WILLIAMS  
CRES.