

City of Prince George
HISTORY SHEET

SHEET NUMBER

PID # 010/41103

Legal: LOTS 65 BLOCK D.L. 913 PLAN 16 511

Address: 188 Mc KENZIE AVE.

Sanitary Connection: # 5721 SIZE 100 mm MATERIAL A.C. INV. 585.940 CONNECTED

Water Connection: # 5721 SIZE 20 mm MATERIAL C.U. METER CONNECTED

Storm Connection: # SIZE mm MATERIAL INV. CONNECTED

Cash Receipt No's: WATER SANITARY STORM

CURB FROM PROPERTY LINE 4.877 m PAVEMENT WIDTH 10.363 m

B.C. HYDRO U/G UNDERGROUND CONNECTION



B.C. TELEPHONE U/G UNDERGROUND CONNECTION

INLAND GAS 3.043 m FROM SOUTH SIDE OF Mc KENZIE.

Information Sheets:

Comments: WITH THAW WIRE.

THE INFORMATION CONTAINED HEREIN IS FOR INTERNAL USE ONLY.
NOT TO BE RELIED UPON UNLESS CONFIRMED BY SITE INSPECTION AND/OR INVESTIGATION

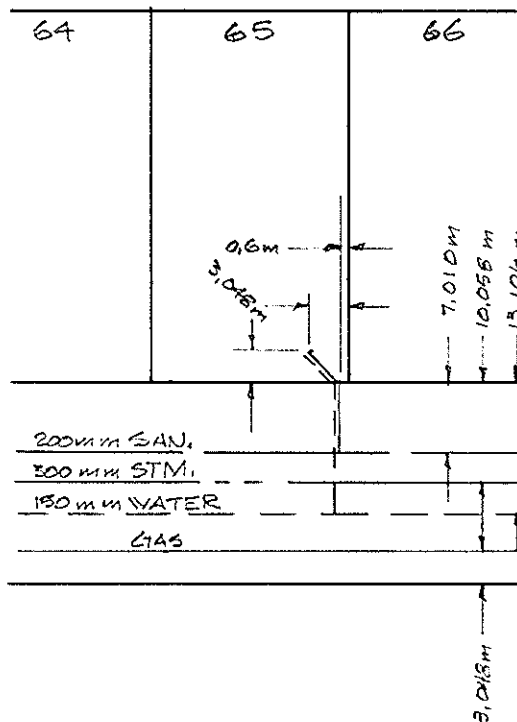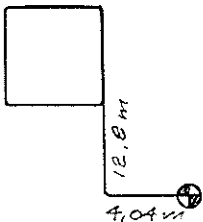

Mc KENZIE AVE.

