



# City of Prince George History Sheet

PID:	010203818
SD/MU:	
WO:	

Civic Address: 1483 Van Bien Ave

Legal Description: Lot: 6 District Lot: 1426 Plan: 20156


Service Type	Diameter (mm)	Material	Invert Elev at main (m)	Invert Elev at property line (m)	Invert Elev at service end (m)	Distance into property (m)	Installation Date
Sanitary	100mm	AC	-	-	-	-	December 1971
Water	20mm	Copper	-	-	-	-	December 1971
Storm	N/A	N/A	-	-	-	-	

Service Connection Location				Sanitary (m)	Storm (m)
Distance from downstream San MH	3866	towards upstream San MH	3865	31.60	
Distance from downstream Stm MH	-	towards upstream Stm MH	-		

Power	Size	Communications	Size	Cable	Size	Gas	Size
BC Hydro	-	Telus	-	Shaw	-	FortisBC	-
Overhead Service		Overhead Service		Overhead Service			

Installed by:	Survey Date:	-
Comments:		

**NOT TO SCALE** The information contained herein is for internal use only.  
Not to be relied on unless confirmed by site inspection and/or investigation.

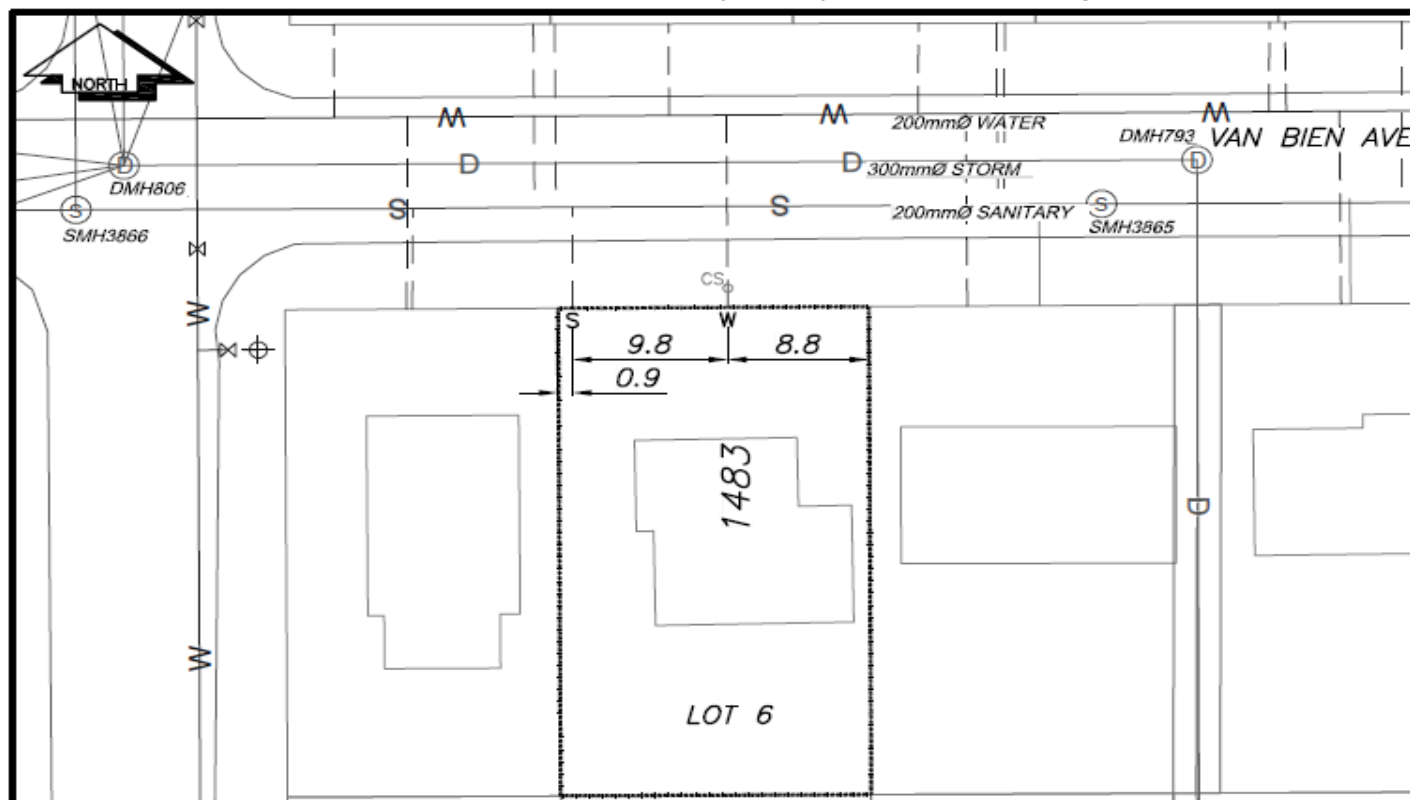

CS <sup>o</sup> CURB STOP	--- W --- WATER SERVICE	--- S --- STORM SERVICE
CO <sup>o</sup> CLEAN OUT	--- S --- SANITARY SERVICE	--- G --- GAS
WATER VALVE	--- FH --- FIRE HYDRANT	--- E --- ENCUMBRANCE

**NOT TO SCALE**