

City of Prince George
HISTORY SHEET

SHEET NUMBER

PID # 010203931

Legal: LOT'S 40 BLOCK D.L. 1426 PLAN 20 156

Address: 1478 PAXTON AVE.

Sanitary Connection: # 7543 SIZE 100 mm MATERIAL A.C. INV. CONNECTED

Water Connection: # 7564 SIZE 20 mm MATERIAL C.U. METER CONNECTED

Storm Connection: # SIZE mm MATERIAL INV. CONNECTED

Cash Receipt No's: WATER SANITARY STORM

CURB FROM PROPERTY LINE 3.962 m PAVEMENT WIDTH 10.363 m

B.C. HYDRO U/G UNDERGROUND CONNECTION



B.C. TELEPHONE U/G UNDERGROUND CONNECTION

INLAND GAS 2.438 m FROM SOUTH SIDE OF PAXTON.

Information Sheets:

Comments: WITH THAW WIRE.

THE INFORMATION CONTAINED HEREIN IS FOR INTERNAL USE ONLY.
NOT TO BE RELIED UPON UNLESS CONFIRMED BY SITE INSPECTION AND/OR INVESTIGATION

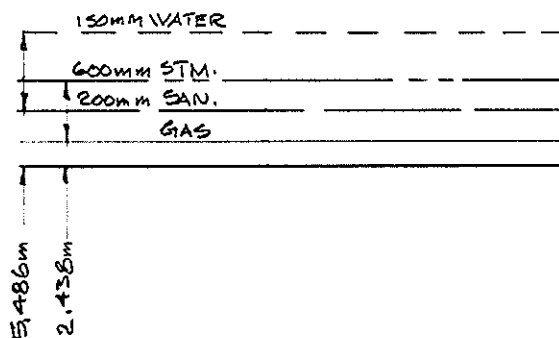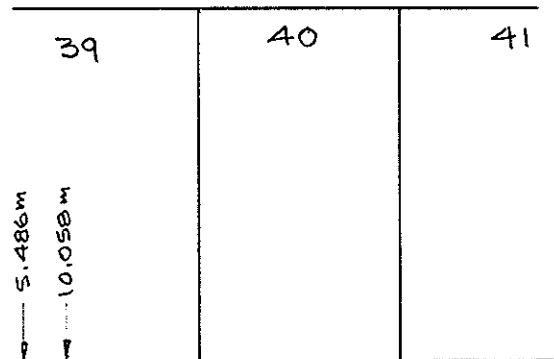

PAXTON AVE.

