



City of Prince George
History Sheet

PID:	010204458
SD/MU:	
WO:	

Civic Address: 1435 Warner Ave

Legal Description: Lot: 16 District Lot: 1426 Plan: 20156


Service Type	Diameter (mm)	Material	-	Invert Elev at property line (m)	Invert Elev at service end (m)	Distance into property (m)	Installation Date
Sanitary	100mm	AC	1.00	-	-	-	December 1971
Water	20mm	Copper	-	-	-	-	December 1971
Storm	N/A	N/A	-	-	-	-	

Service Connection Location						Sanitary (m)	Storm (m)
Distance from downstream San MH		-	towards upstream San MH	-	-	-	
Distance from downstream Stm MH		-	towards upstream Stm MH	-	-		

Power	Size	Communications	Size	Cable	Size	Gas	Size
BC Hydro	-	Telus	-	Shaw	-	FortisBC	-
Overhead Service		Overhead Service		Overhead Service			

Installed by:	City of Prince George forces	Survey Date:	-
Comments:			

NOT TO SCALE The information contained herein is for internal use only.
Not to be relied on unless confirmed by site inspection and/or investigation.

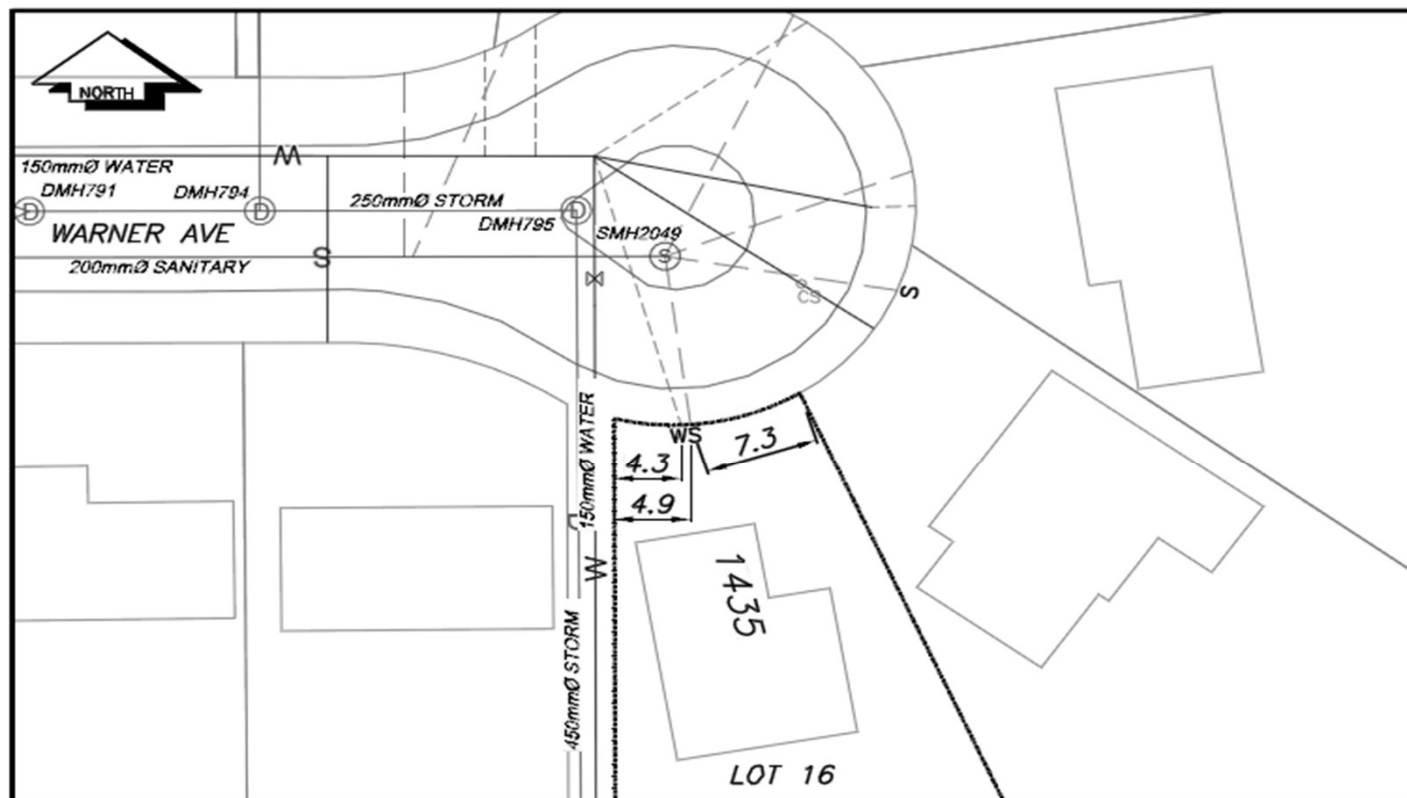

CS	CURB STOP	W	WATER SERVICE	Ø	STORM SERVICE
CO	CLEAN OUT	S	SANITARY SERVICE	G	GAS
WV	WATER VALVE	FH	FIRE HYDRANT	---	ENCUMBRANCE

NOT TO SCALE