

City of Prince George  
HISTORY SHEET

SHEET NUMBER

PID # 010212779

Legal: LOT'S 12 BLOCK D.L. 2608 PLAN 20 043

Address: 4381 FIRST AVE.

Sanitary Connection: # 7559 SIZE 100 mm MATERIAL A.C. INV. CONNECTED ✓

Water Connection: # 7579 SIZE 20 mm MATERIAL C.U. METER CONNECTED ✓

Storm Connection: # SIZE mm MATERIAL INV. CONNECTED

Cash Receipt No's: WATER SANITARY 5 STORM

CURB FROM PROPERTY LINE 5.791 PAVEMENT WIDTH 12.801 m

B.C. HYDRO U/G UNDERGROUND CONNECTION


B.C. TELEPHONE U/G UNDERGROUND CONNECTION

INLAND GAS 3.048 m FROM R.L.

Information Sheets:

Comments:

THE INFORMATION CONTAINED HEREIN IS FOR INTERNAL USE ONLY.  
NOT TO BE RELIED UPON UNLESS CONFIRMED BY SITE INSPECTION AND/OR INVESTIGATION

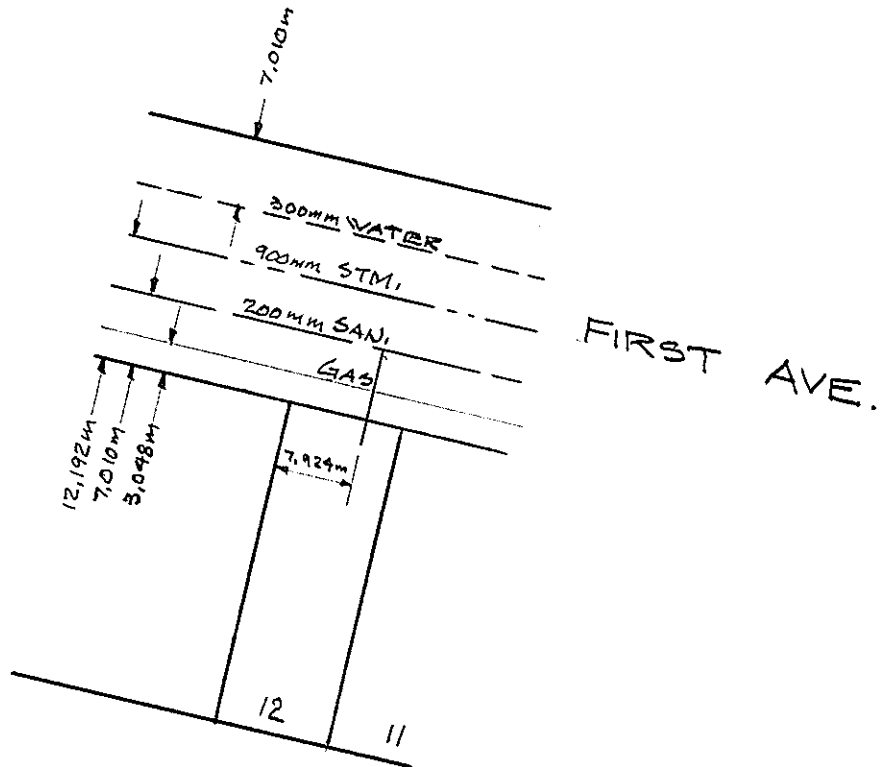


## REPORT TO RECORDS

## WATER SERVICE INFORMATION

Lot No. 12 Block 1 D.L. 2608Address 4381 1ST AVENUESize of Connection ☐ 1/2" ☐ 3/4" ☐ Other \_\_\_\_\_Type of Connection ☐ Copper ☐ IronThaw Wire ☐ Yes ☐ No PL 20043

## LOCATION SKETCH

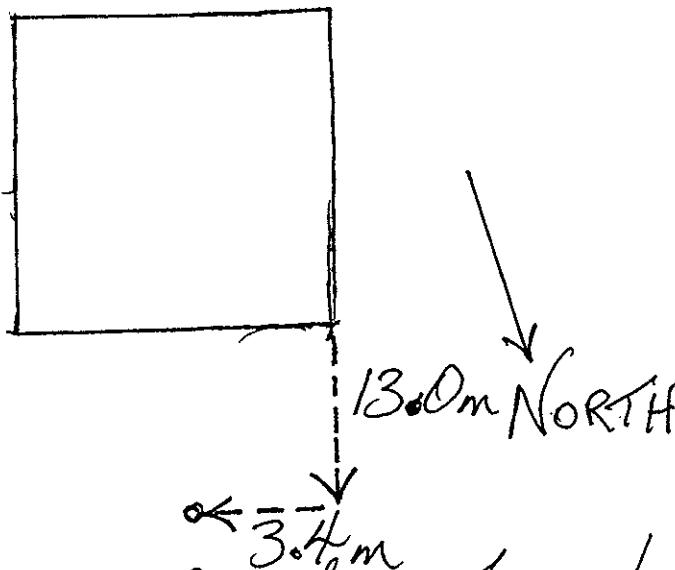Field Location By WR Bond Date June 10/87

Checked by: \_\_\_\_\_