

City of Prince George
HISTORY SHEET

SHEET NUMBER

PID # 010212795

Legal: LOTS 27 BLOCK D.L. 2608 PLAN 20 043

Address: 4441 FIRST AVE.

Sanitary Connection: # SIZE 100 mm MATERIAL A.C. INV. CONNECTED

Water Connection: # SIZE 20 mm MATERIAL C.U. METER CONNECTED

Storm Connection: # SIZE mm MATERIAL INV. CONNECTED

Cash Receipt No's: WATER SANITARY STORM

CURB FROM PROPERTY LINE 5.791 m PAVEMENT WIDTH 12.801 m

B.C. HYDRO U/G UNDERGROUND CONNECTION


B.C. TELEPHONE U/G UNDERGROUND CONNECTION

INLAND GAS 3.048 m FROM R.

Information Sheets:

Comments:

THE INFORMATION CONTAINED HEREIN IS FOR INTERNAL USE ONLY.
NOT TO BE RELIED UPON UNLESS CONFIRMED BY SITE INSPECTION AND/OR INVESTIGATION

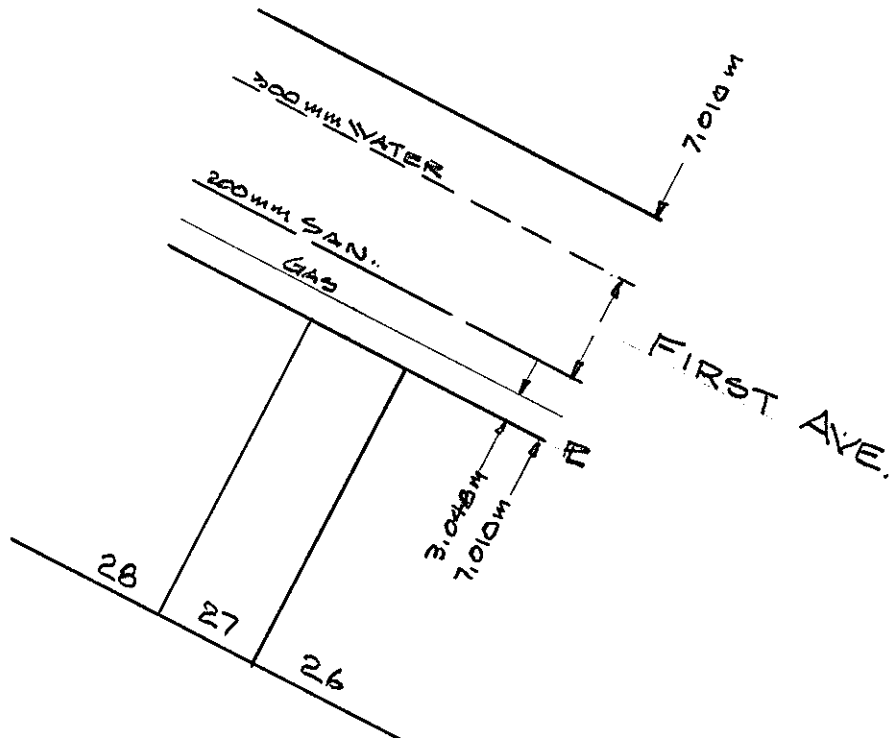

REPORT TO RECORDS


WATER SERVICE INFORMATION

010212795

Lot No. 27 Block D.L. 2608Address 4441 1ST AVENUESize of Connection ☐ 1/2" ☐ 3/4" ☐ Other Type of Connection ☐ Copper ☐ IronThaw Wire ☒ Yes ☐ No

PL 20043

LOCATION SKETCH

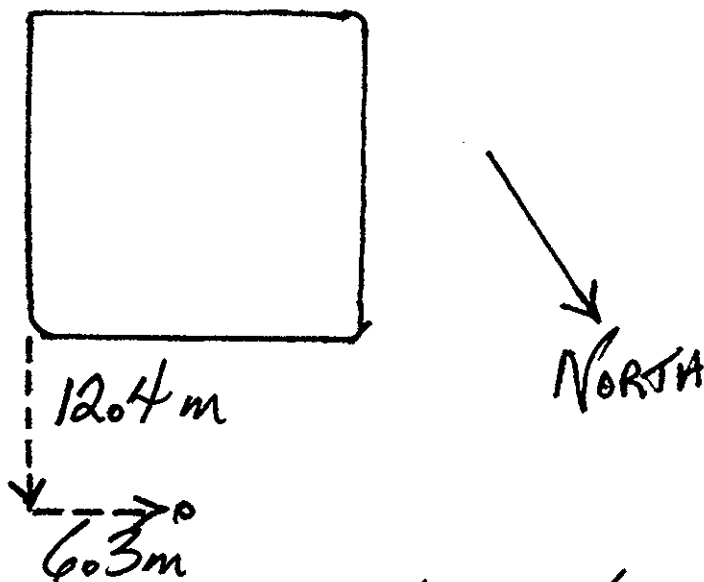

Field Location By

W Bond

Date

May 27/87Checked by: