

City of Prince George
HISTORY SHEET

SHEET NUMBER

Roll Number 010213066

Legal: LOT'S 13 BLOCK D.L. 2608 PLAN 20 043

Address: 4385 FIRST AVE.

Sanitary Connection: # 7560 SIZE 100 mm MATERIAL A.C. INV. CONNECTED

Water Connection # 7580 SIZE 20 mm MATERIAL C.U. METER CONNECTED

Storm Connection: # SIZE MATERIAL INV. CONNECTED

Cash Receipt No's: WATER SANITARY STORM

CURB FROM PROPERTY LINE 5.791 m PAVEMENT WIDTH 12.801 m

B.C. HYDRO U/G UNDERGROUND CONNECTION


B.C. TELEPHONE U/G UNDERGROUND CONNECTION

INLAND GAS AS SHOWN

Information Sheets:

Comments: WITH THAW WIRE,

THE INFORMATION CONTAINED HEREIN IS FOR INTERNAL USE ONLY.
NOT TO BE RELIED UPON UNLESS CONFIRMED BY SITE INSPECTION AND/OR INVESTIGATION

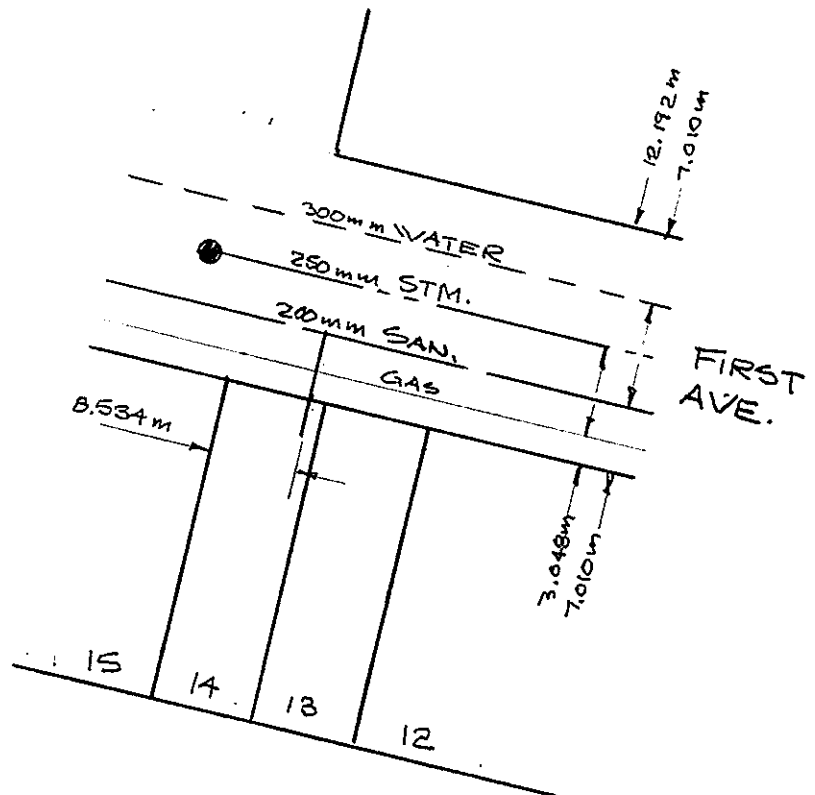


JUN 12 1987

REPORT TO RECORDS

WATER SERVICE INFORMATION

Lot No. 13 Block — D.L. 2608Address 4385 1ST AVENUESize of Connection ☐ 1/2" ☐ 3/4" ☐ Other —Type of Connection ☐ Copper ☐ IronThaw Wire ☐ Yes ☐ No*PL 20043*

LOCATION SKETCH

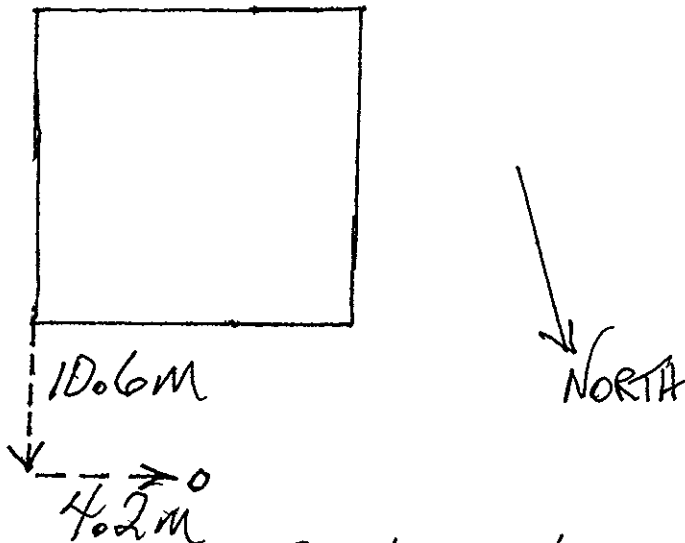Field Location By *W. Bond* Date *June 10/87*Checked by: —