

City of Prince George
HISTORY SHEET

SHEET NUMBER

PID # 010213082

Legal: LOT'S 14 BLOCK D.L. 2608 PLAN 20 043

Address: 4389 FIRST AVE.

Sanitary Connection: # 7330 SIZE 100 mm MATERIAL A.C. INV. CONNECTED

Water Connection: # 7330 SIZE 20 mm MATERIAL C.U. METER CONNECTED

Storm Connection: # SIZE mm MATERIAL INV. CONNECTED

Cash Receipt No's: WATER SANITARY STORM

CURB FROM PROPERTY LINE 5.791 m PAVEMENT WIDTH 12.801 m

B.C. HYDRO U/G UNDERGROUND CONNECTION


B.C. TELEPHONE U/G UNDERGROUND CONNECTION

INLAND GAS 3.048 m FROM P.L.

Information Sheets:

Comments:

THE INFORMATION CONTAINED HEREIN IS FOR INTERNAL USE ONLY.
NOT TO BE RELIED UPON UNLESS CONFIRMED BY SITE INSPECTION AND/OR INVESTIGATION

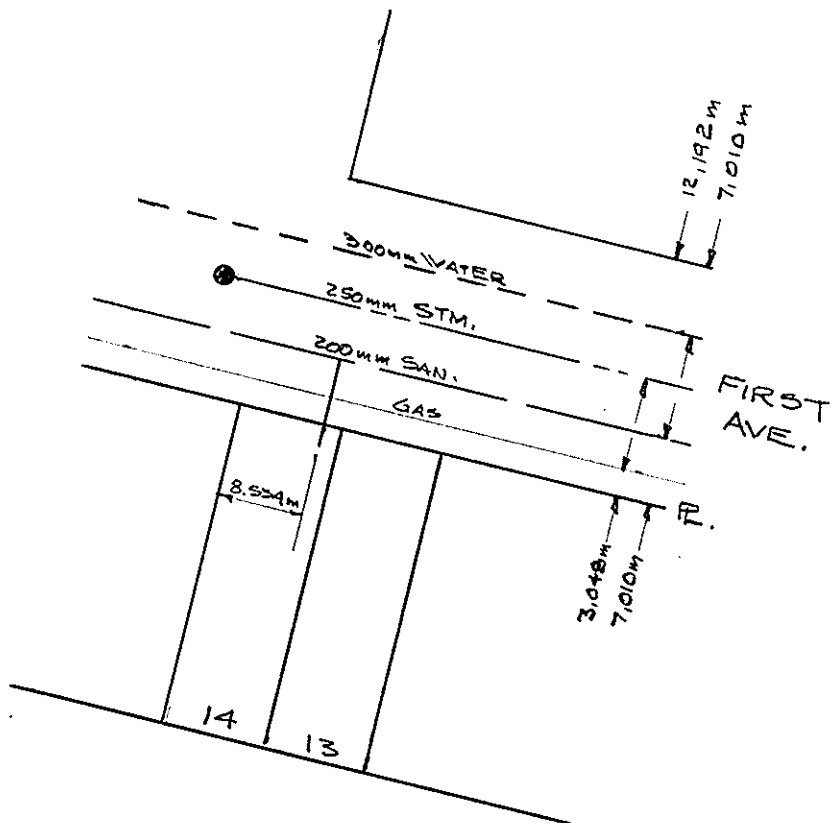

JUN 12 1987


REPORT TO RECORDS

WATER SERVICE INFORMATION

Lot No. 19 Block D.L. 2608Address 4389 18th AVENUESize of Connection ☐ 1/2" ☐ 3/4" ☐ Other Type of Connection ☐ Copper ☐ IronThaw Wire ☐ Yes ☐ No

P.L. 20043

LOCATION SKETCH

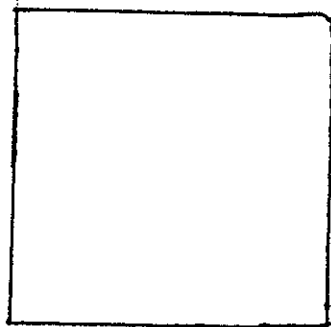

Field Location By

W Bond

Date

June 19/87Checked by: