



City of Prince George History Sheet

PID:	010285717
SD/MU:	
WO:	

Civic Address: 6388 Lalonde Rd

Legal Description: Lot: 10 District Lot: 2003 Plan: 13053


Service Type	Diameter (mm)	Material	Invert Elev at main (m)	Invert Elev at property line (m)	Invert Elev at service end (m)	Distance into property (m)	Installation Date
Sanitary	100mm	PVC	-	-	-	-	January 1983
Water	20mm	Copper	-	-	-	-	January 1978
Storm	N/A	N/A	-	-	-	-	

Service Connection Location				Sanitary (m)	Storm (m)
Distance from downstream San MH	4167	towards upstream San MH	4238	45.86	
Distance from downstream Stm MH	-	towards upstream Stm MH	-		

Power	Size	Communications	Size	Cable	Size	Gas	Size
BC Hydro	-	Telus	-	Shaw	-	FortisBC	-
Not Applicable		Not Applicable		Not Applicable			

Installed by:	Survey Date:	-
Comments: San service confirmed on Mar 2017 by camera. Wat service confirmed Feb 2017 by UTOPS.		

NOT TO SCALE The information contained herein is for internal use only.
Not to be relied on unless confirmed by site inspection and/or investigation.

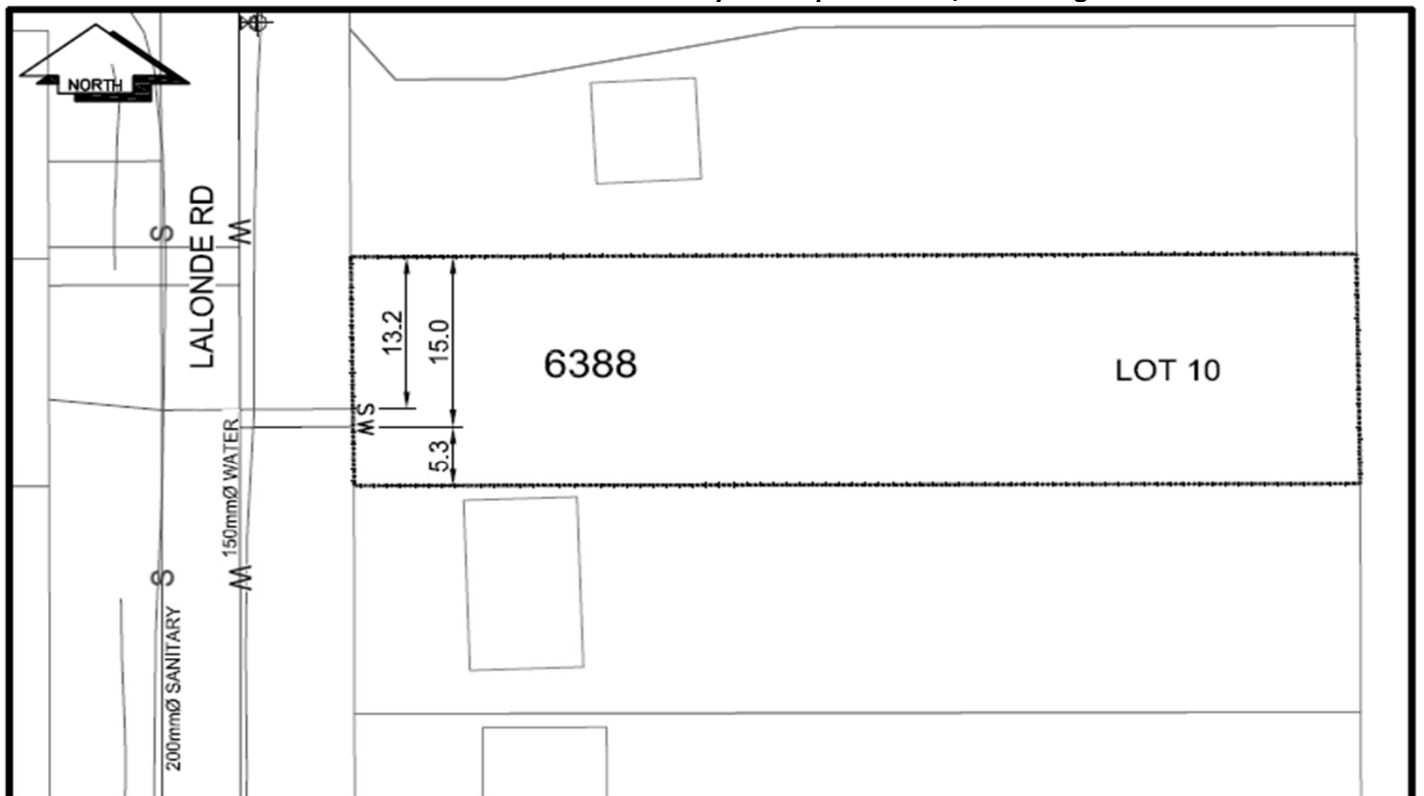

CS ^o CURB STOP	— W — WATER SERVICE	— S — STORM SERVICE
CO ^o CLEAN OUT	- - - S - SANITARY SERVICE	— G — GAS
⊗ WATER VALVE	⊗ FIRE HYDRANT	- - - - ENCUMBRANCE

NOT TO SCALE