


## Lot Servicing

**7111 DAGG RD**


**PID: 010353933**

**Lot: B, Plan: 19750, DL: 4047**

SERVICE	SIZE	MATERIAL	INSTALLED DATE	LOCATION	DETAILS
WATER	20MM	CU	25-Jun-1981	1.0M N S PL	CASH RECEIPT NUMBER 508
SANITARY	100MM	PVC	25-Jun-1981	17.2M N S PL	CLEANOUT Y

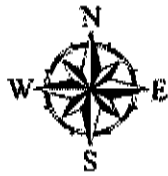

- Sanitary
- - Storm
- - Water
- 25 Lot Number

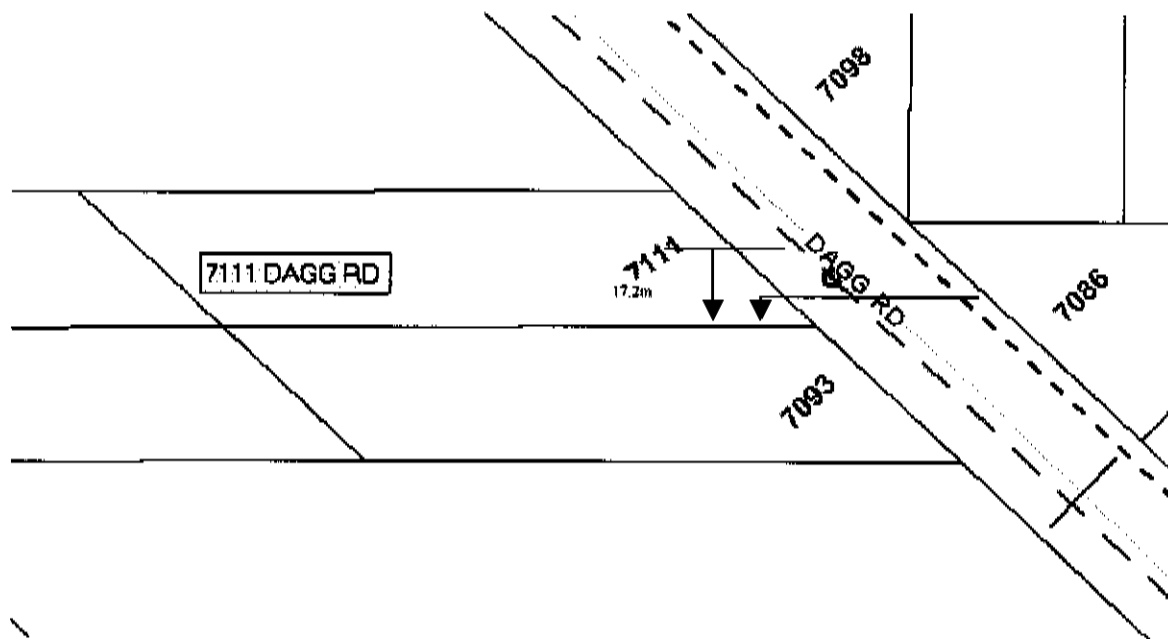

Accuracy not guaranteed unless confirmed by site inspection and/or investigation.  
Connection location between main and property line only.